

15-095-00092-0000


STATE OF KANSAS
STATE CORPORATION COMMISSION

WELL PLUGGING RECORD

Give All Information Completely
Make Required Affidavit
Mail or Deliver Report to:
Conservation Division
State Corporation Commission
800 Bitting Building
Wichita, Kansas

Kingman County. Sec. 1 Twp. 30 Rge. (E) 9 (W)
Location as "NE/CNW/SW" or footage from lines NE SE NW
Lease Owner Rupp-Ferguson Oil Co.
Lease Name Adelhart Well No. 1
Office Address 523 Petroleum Bldg., Wichita, Kansas
Character of Well (completed as Oil, Gas or Dry Hole) Dry Hole
Date well completed 4-12-55 19
Application for plugging filed 4-13-55 19
Application for plugging approved 4-13-55 19
Plugging commenced 4-13-55 19
Plugging completed 4-13-55 19
Reason for abandonment of well or producing formation

NORTH

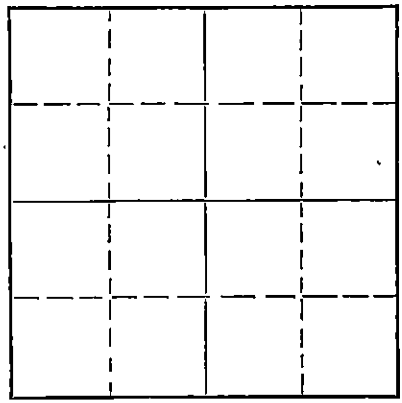

Locate well correctly on above
Section Plat

If a producing well is abandoned, date of last production 19
Was permission obtained from the Conservation Division or its agents before plugging was commenced? Yes

Name of Conservation Agent who supervised plugging of this well
Producing formation Depth to top Bottom Total Depth of Well 4230' Feet
Show depth and thickness of all water, oil and gas formations.

OIL, GAS OR WATER RECORDS

CASING RECORD

FORMATION	CONTENT	FROM	TO	SIZE	PUT IN	PULLED OUT
				8 5/8	273'	0

Describe in detail the manner in which the well was plugged, indicating where the mud fluid was placed and the method or methods used in introducing it into the hole. If cement or other plugs were used, state the character of same and depth placed, from feet to feet for each plug set.

Filled w/mud to 250, hulls and plug @ 250', 20 sacks cement.
Mud to 40', hulls and plug, filled to base of cellar w/cement.

4-19-55
RECEIVED
STATE CORPORATION COMMISSION
APR 19 1955
CONSERVATION DIVISION
Wichita, Kansas

(If additional description is necessary, use BACK of this sheet)
Name of Plugging Contractor Rupp-Ferguson Oil Co.
Address 523 Petroleum Bldg., Wichita, Kansas

STATE OF Kansas, COUNTY OF Sedgwick, ss.
L. W. Knox (employee of owner) or (owner or operator) of the above-described well, being first duly sworn on oath, says: That I have knowledge of the facts, statements, and matters herein contained and the log of the above-described well as filed and that the same are true and correct. So help me God.

(Signature) L. W. Knox
523 Petroleum Bldg., Wichita, Kansas
(Address)

SUBSCRIBED AND SWORN TO before me this 18th day of April, 1955

Helen Horine
Notary Public.

My commission expires June 4, 1955

PLUGGING
FILE SEC 1 T 30 R 9 W
BOOK PAGE 111 LINE 23

CONTRACTOR'S WELL LOG

Rupp-Ferguson No. 1 Adelhart
NE SE NW, Sec. 1-30-9W,
Kingman County, Kansas

Contractor: Rupp-Ferguson Oil Co.

Elevation 1554 KB

Commenced: 3-31-55

Completed: 4-12-55

D & A

Set 273' of 8 5/8" surface casing w/250 sacks cement

Figures Indicate Bottom of Formation

- 45 sand
- 273 red bed
- 885 red bed & shale
- 1100 salt
- 3234 lime & shale
- 3360 shale & sand
- 3460 sand
- 4014 lime
- 4170 lime & shale
- 4177 shale
- 4230 Miss.
T.D.

STATE OF KANSAS)
) SS:
COUNTY OF SEDGWICK)

I, L. W. Knox, Landman for Rupp-Ferguson Oil Co., do hereby certify that the above and foregoing is a true and correct copy of the log of the No. 1 Adelhart well.

L. W. Knox
L. W. Knox

Subscribed and sworn to before me this 18th day of April, 1955.

Helen Horine
Notary Public

My Commission Expires June 4, 1955.

RECEIVED
STATE CORPORATION COMMISSION
APR 19 1955
PLUGGING
CONSERVATION DIVISION
Wichita, Kansas
FILED SEC 1 T 30 R 9 W
BOOK PAGE 111 LINE 23