


WELL PLUGGING RECORD

Give All Information Completely
Make Required Affidavit
Mail or Deliver Report to:
Conservation Division
State Corporation Commission
800 Pitting Building
Wichita, Kansas

NORTH

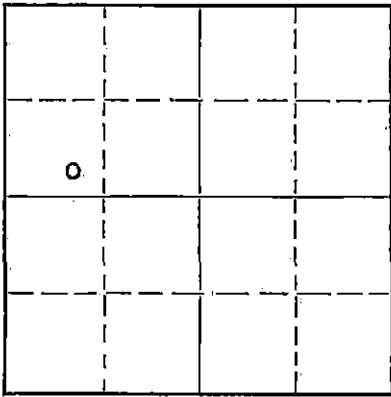

Locate well correctly on above
Section Flat

Stafford County. Sec. 30 Twp. 24S Rge. 13 (E) (W)
Location as "NE/CNW $\frac{1}{4}$ SW $\frac{1}{4}$ " or footage from lines SE/C SW/4 NW/4
Lease Owner L.B. Stableford
Lease Name Aitken Well No. 3
Office Address 333 North Michigan Avenue, Chicago, Illinois
Character of Well (completed as Oil, Gas or Dry Hole) Dry Hole
Date well completed 9/20/50 19.
Application for plugging filed October 12, 19 50
Application for plugging approved October 18, 19 50
Plugging commenced October 14, 19 50
Plugging completed October 16, 19 50
Reason for abandonment of well or producing formation

If a producing well is abandoned, date of last production 19.
Was permission obtained from the Conservation Division or its agents before plugging was commenced? Yes

Name of Conservation Agent who supervised plugging of this well C.D. Stough
Producing formation Depth to top Bottom Total Depth of Well 4203 Feet
Show depth and thickness of all water, oil and gas formations.

OIL, GAS OR WATER RECORDS

CASING RECORD

Formation	Content	From	To	Size	Put In	Pulled Out
				8 5/8"	239'	none
				5 1/2"	4202'	3407'

Describe in detail the manner in which the well was plugged, indicating where the mud fluid was placed and the method or methods used in introducing it into the hole. If cement or other plugs were used, state the character of same and depth placed, from feet to feet for each plug set.

L.W.P. set @ 3680'
Plugged back from 3680' to 3640' with crushed rock, dumped 5 sax cement at 3640' with dump bailer. Top of cement, 3600'. Filled hole with mud to 239', set rock bridge, dumped 15 sax cement. Top of cement 180'. Filled with mud to 30', set rock bridge, dumped 10 sax cement for cap.

10-30-50

RECEIVED
STATE CORPORATION COMMISSION
OCT 30 1950
CONSERVATION DIVISION
Wichita, Kansas

(If additional description is necessary, use BACK of this sheet)

Correspondence regarding this well should be addressed to Clinton Engstrand of K & E DRILLING, INC.
Address 612 Union National Bank Bldg, Wichita 2, Kansas

STATE OF Kansas, COUNTY OF Sedgwick, ss.
Clinton Engstrand agent for (employee of/owner) or (owner or operator) of the above-described well,
being first duly sworn on oath, says: That I have knowledge of the facts, statements, and matters herein contained and the log of the above-described well as filed and that the same are true and correct. So help me God.

(Signature) *Clinton Engstrand*
612 Union National Bank Bldg, Wichita
(Address)

SUBSCRIBED AND SWORN to before me this 27th day of October, 19 50.

My commission expires 6-5-54

B. Dudsmyre
Notary Public.

PLUGGING
FILE SEC 20 T 24 R 34
BOOK PAGE 36 LINE 13

15-185-12076-0000

L. B. STABLEFORD
AITKEN # 3

SE SW NW Sec. 30 Twp. 24S Rge. 13W
Stafford County, Kansas

Total Depth: 4203'
Comm: 9/3/50
Comp: 9/20/50

Casing	Cement
8 5/8" Set @ 239'	175 Sacks
5 1/2" Set @ 4202'	150 Sacks

Formation	Depth
Sand	0 - 100
Shale & sand	100 - 239
Red bed & shale	239 - 820
Anhydrite	820 - 840
Shale & shells	840 - 1570
Lime & shale	1570 - 2290
Shale & lime shale	2290 - 2415
Shale & shells	2415 - 2850
Lime and shale	2850 - 3305
Lime	3305 - 3470
Shale & lime	3470 - 3660
Lime	3660 - 3875
Shale & lime	3875 - 4000
Lime, chert & shale	4000 - 4034
Shale & lime	4034 - 4085
Cherty Lime	4085 - 4130
Lime & chert	4130 - 4155
Shale & lime	4155 - 4170
Sand & shale	4170 - 4201
Lime	4201 - 4203

STATE OF KANSAS)
) SS
BEDGWICK COUNTY)

I hereby certify that the above information is true and correct to the best of my knowledge.

Subscribed and sworn to before me this 29th day of September, 1950.
OCT 30 1950

PLUGGING
CONSERVATION DIVISION
Wichita, Kansas
FILE SEC 20-T-4-R-130
NOV 3 6-5-54

[Signature]
Notary Public