


STATE OF KANSAS
STATE CORPORATION COMMISSION

Give All Information Completely
Make Required Affidavit
Mail or Deliver Report to
Conservation Division
State Corporation Commission
211 No. Broadway
Wichita, Kansas

15-185-19035-0001
Form CP-4

WELL PLUGGING RECORD

NORTH

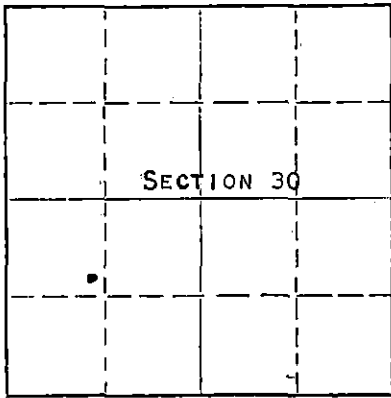

Locate well correctly on above
Section Plat

STAFFORD

County. Sec. 30 Twp. 24s Rge. 13w (#) (W)

Location as "NE/CNW/SW" or footage from lines SE NW SW

Lease Owner PETROLEUM, INC.

Lease Name HARTER "G"

Well No. 1

Office Address ROUTE 2, GREAT BEND, KANSAS

Character of Well (completed as Oil, Gas or Dry Hole) DRY HOLE

Date well completed AUGUST 26, 19 62

Application for plugging filed AUGUST 26, 19 62

Application for plugging approved AUGUST 26, 19 62

Plugging commenced AUGUST 26, 19 62

Plugging completed AUGUST 26, 19 62

Reason for abandonment of well or producing formation NO PRODUCIBLE FORMATIONS

If a producing well is abandoned, date of last production NONE 19

Was permission obtained from the Conservation Division or its agents before plugging was commenced? YES

Name of Conservation Agent who supervised plugging of this well W. L. LACKAMP, JR.

Producing formation --- Depth to top --- Bottom --- Total Depth of Well 4025 Feet

Show depth and thickness of all water, oil and gas formations.

OIL, GAS OR WATER RECORDS

CASING RECORD

FORMATION	CONTENT	FROM	TO	SIZE	PUT IN	PULLED OUT
				8-5/8"	242'	NONE

Describe in detail the manner in which the well was plugged, indicating where the mud fluid was placed and the method or methods used in introducing it into the hole. If cement or other plugs were used, state the character of same and depth placed, from feet to feet for each plug set.

MUDDED UP WITH HEAVY MUD TO 220' FOLLOWED BY WOODEN PLUG. PLACED 20 SACKS CEMENT ONTO PLUG THROUGH DRILL PIPE. MUDDED UP WITH HEAVY MUD TO 40' FOLLOWED BY WOODEN PLUG AND 10 SACKS CEMENT TO BASE OF WELL CELLAR.

RECEIVED
STATE CORPORATION COMMISSION
SEP 13 1962
CONSERVATION DIVISION
Wichita, Kansas

9-13-62

(If additional description is necessary, use BACK of this sheet)

Name of Plugging Contractor GARVEY DRILLING COMPANY

Address ROUTE 2, GREAT BEND, KANSAS

STATE OF KANSAS, COUNTY OF BARTON, ss.
DON SEARLE (employee of owner) or (owner or operator) of the above-described

well, being first duly sworn on oath, says: That I have knowledge of the facts, statements, and matters herein contained and the log of the above-described well as filed and that the same are true and correct. So help me God DON SEARLE, DIST. PROD. SUPT.

(Signature)

ROUTE 2, GREAT BEND, KANSAS

(Address)

SUBSCRIBED AND SWORN to before me this 10TH day of SEPTEMBER, 19 62

My commission expires APRIL 14, 1963.

Notary Public.

WELL LOG

15-185-19035-0001

COMPANY PETROLEUM, INCORPORATED

SEC. 30 T-24S-R. 13W

FARM HARTER "G" NO. 1

LOC. SE, NW, SW


TOTAL DEPTH 4025'

COUNTY STAFFORD CO., KANSAS

COMM. August 23, 1962 COMP. August 26, 1962

CONTRACTOR GARVEY DRILLING COMPANY

CASING 8-5/8" @ 242'

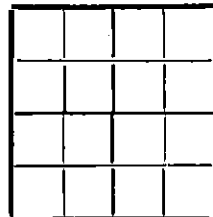

ELEVATION 1942' K.B.

PRODUCTION D & A

FIGURES INDICATE BOTTOM OF FORMATIONS

0 to 3798'
3895
3960
4025
4025

Old hole wash-down.
Lime
Lime & shale
Lime
T. D.

RECEIVED
STATE CORPORATION COMMISSION
SEP 13 1962
CONSERVATION DIVISION
Wichita, Kansas

State of KANSAS }
County of BARTON } 38

I, VERNE A. MORRIS of GARVEY DRILLING COMPANY

upon oath state the above and foregoing is a true and correct copy of the log of the #1 HARTER "G" well.

Subscribed and sworn to before me this 5th day of September 19 62

My Commission Expires: April 14, 1963

Arthur J. Miles
NOTARY PUBLIC