


WELL PLUGGING RECORD

Give All Information Completely
Make Required Affidavit
Mail or Deliver Report to:
Conservation Division
State Corporation Commission
800 Bitting Building
Wichita, Kansas

Stafford County, Sec. 30 Twp. 24S Rge. (E) 13 (W)

Location as "NE/CNW/SW" or footage from lines NE NE SW
Lease Owner L. B. Stableford
Lease Name Harter Well No. 1
Office Address 1005 Central Bldg., Wichita, Kansas
Character of Well (completed as Oil, Gas or Dry Hole) Oil
Date well completed Feb. 21 1950
Application for plugging filed Oct. 17 1952
Application for plugging approved Oct. 17 1952
Plugging commenced Oct. 20 1952
Plugging completed Oct. 23 1952
Reason for abandonment of well or producing formation Depleted

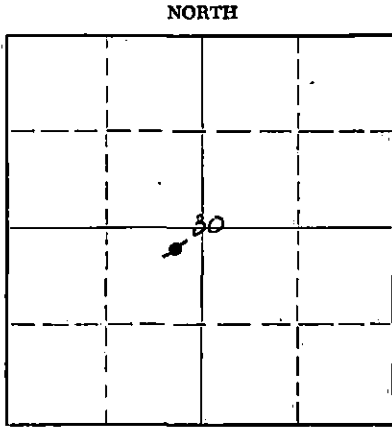

Locate well correctly on above Section Plat

If a producing well is abandoned, date of last production Jan. 18 1952
Was permission obtained from the Conservation Division or its agents before plugging was commenced? Yes

Name of Conservation Agent who supervised plugging of this well M. A. Rives
Producing formation Simpson Depth to top _____ Bottom _____ Total Depth of Well 4250 Feet
Show depth and thickness of all water, oil and gas formations.

OIL, GAS OR WATER RECORDS

CASING RECORD

| FORMATION | CONTENT | FROM | TO | SIZE | PUT IN | PULLED OUT |
|-----------|---------|------|------|--------|--------|------------|
| Simpson | Oil | 4166 | 4190 | 8 5/8" | 301' | none |
| | | | | 5 1/2" | 4207' | 2020' |
| | | | | | | |
| | | | | | | |
| | | | | | | |
| | | | | | | |
| | | | | | | |

Describe in detail the manner in which the well was plugged, indicating where the mud fluid was placed and the method or methods used in introducing it into the hole. If cement or other plugs were used, state the character of same and depth placed, from _____ feet to _____ feet for each plug set.

Plugged back from total depth to 3838' with Lane Wells Plug.
Plugged back to 3670' with sand and 5 sacks cement. Shot casing off and pulled out pipe. Filled hole with 15 sacks mud and 75 sacks cement.

STATE CORPORATION COMMISSION
CONSERVATION DIVISION
Wichita, Kansas

12-17-52

(If additional description is necessary, use BACK of this sheet)
Name of Plugging Contractor Forbes Casing Pulling Co.
Address Great Bend, Kansas

STATE OF KANSAS, COUNTY OF SEDGWICK, ss.
R. D. Reber (employee of owner) or (contractor/operator) of the above-described well, being first duly sworn on oath, says: That I have knowledge of the facts, statements, and matters herein contained and the log of the above-described well as filed and that the same are true and correct. So help me God.

(Signature) R. D. Reber
1005 Central Bldg., Wichita, Kansas
(Address)

SUBSCRIBED AND SWORN TO before me this 16th day of December, 1952

My commission expires April 14, 1956

Eleanor Doty
Notary Public.

PLUGGING
FILE SEC. 30 Twp. 24 R. 13
BOOK PAGE 52 LINE 43

L. B. STABLEFORD
 WARTER #1

NE NE SW
 Sec. 30, Twp. 24, Rge. 13W
 Stafford County, Kansas

Total Depth: 4250'
 Comm: 12/2/49
 Comp: 12/23/49

Casing

Cement

8 5/8" set @ 301'
 5 1/2" set @ 4205'

250 sacks
 125 sacks

| <u>Formation</u> | <u>Depth</u> |
|---------------------|--------------|
| Sand | 40 |
| Sand | 185 |
| Shale-Shells | 301 |
| Red Sandy Shale | 730 |
| Red Bed | 846 |
| Anhydrite | 868 |
| Shale | 900 |
| Red Bed | 980 |
| Shale-Shells | 1372 |
| Shale-Salt | 1527 |
| Shale Lime-Shells | 1620 |
| Shale-Shells | 1780 |
| Anhydrite | 1890 |
| Shale-Lime | 2010 |
| Sandy Lime | 2075 |
| Sandy Lime | 2175 |
| Shale-Lime | 2380 |
| Shale-Shells | 2490 |
| Lime-Shale | 3251 |
| Lime | 3466 |
| Lime-Shale | 3552 |
| Shale | 3614 |
| Lime | 3900 |
| Shale-Lime | 3930 |
| Conglomerate Cherty | 3963 |
| Chert | 3990 |
| Lime-Chert | 4126 |
| Lime | 4195 |
| Shale-Lime | 4202 |
| Lime | 4250 |

STATE OF KANSAS)
) SS
 COUNTY OF SEDGWICK)

I hereby certify that the above information is true and correct to the best of my knowledge.

[Handwritten Signature]

Subscribed and sworn to before me this 17th day of October, 1952.

[Handwritten Signature]
 Notary Public

My commission expires: April 14, 1956

PLUGGING
 FILE SEC-30 T-24 R-13W
 BOOK PAGE 52 LINE 42