


STATE OF KANSAS
STATE CORPORATION COMMISSION

WELL PLUGGING RECORD

Give All Information Completely
Make Required Affidavit
Mail or Deliver Report to:
Conservation Division
State Corporation Commission
211 No. Broadway
Wichita, Kansas

Stafford County, Sec. ³⁰~~20~~ Twp. 24 Rge. 13 (E) W (W)
Location as "NE/CNW/SW" or footage from lines NW/NE/SW
Lease Owner Petroleum Management Inc.
Lease Name Harter Well No. 2
Office Address 1515 Wichita Plaza Wichita, Ks.
Character of Well (completed as Oil, Gas or Dry Hole) Oil
Date well completed _____ 19____
Application for plugging filed _____ 19____
Application for plugging approved _____ 19____
Plugging commenced _____ July 11, 19 64
Plugging completed _____ July 13, 19 64
Reason for abandonment of well or producing formation No longer a producer.

NORTH

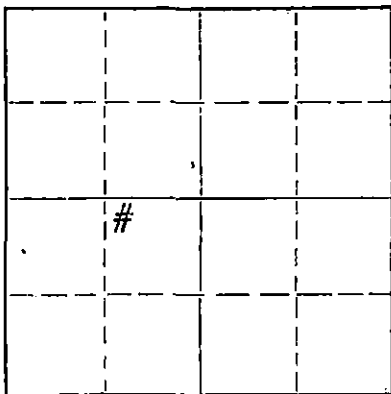

Locate well correctly on above
Section Plat

If a producing well is abandoned, date of last production _____ 19____
Was permission obtained from the Conservation Division, or its agents before plugging was commenced? Yes

Name of Conservation Agent who supervised plugging of this well Archie Elving
Producing formation _____ Depth to top _____ Bottom _____ Total Depth of Well 4188 Feet
Show depth and thickness of all water, oil and gas formations. PBTD 4162'

OIL, GAS OR WATER RECORDS

CASING RECORD

FORMATION	CONTENT	FROM	TO	SIZE	PUT IN	PULLED OUT
				8 5/8	244'	None
				5 1/2	4181'	3019'

Describe in detail the manner in which the well was plugged, indicating where the mud fluid was placed and the method or methods used in introducing it into the hole. If cement or other plugs were used, state the character of same and depth placed, from _____ feet to _____ feet for each plug set.

Plugged back with sand from 3975' to 3750'. Mixed and dumped 5
sx. of cement from 3750' to 3710'. Pulled casing.
Mixed and pumped in 10 sx. of gel mud. Put in plug. Mixed and
pumped in 75 sx. of cement from 225' to base of the cellar.

RECEIVED
STATE CORPORATION COMMISSION

AUG 24 1964

CONSERVATION DIVISION
Wichita, Kansas

RECEIVED
STATE CORPORATION COMMISSION

AUG 20 1964

CONSERVATION DIVISION
Wichita, Kansas

8-24-64

(If additional description is necessary, use BACK of this sheet)

Name of Plugging Contractor Ace Pipe Pulling Co.
Address Box 304 Great Bend, Ks.

STATE OF Kansas COUNTY OF Barton, ss.
A. J. Jones (employee of owner) or (owner or operator) of the above-described well, being first duly sworn on oath, says: That I have knowledge of the facts, statements, and matters herein contained and the log of the above-described well as filed and that the same are true and correct. So help me God.

(Signature) _____

(Address) _____

SUBSCRIBED AND SWORN TO before me this 18th day of August, 1964

My commission expires Jan 17 1965

Notary Public.

D.B. STABLEFORD
R. HARTER "A" # 2

NW NE SW Sec.30 Twp.24S Rge.13W
Stafford County, Kansas

Total Depth: 4188'
Comm: 6/1/50
Comp: 6/18/50

Casing

8 5/8" Set @ 244'
5 1/2" Set @ 4181'

Cement

175 Sacks
200 Sacks

Formation	Depth
Shale and Sand	0 - 244
Shale and Red Bed	244 - 820
Anhydrite	820 - 845
Shale	845 - 1175
Shale and Lime Shells	1175 - 1630
Shale and Lime	1630 - 2185
Shale and sandy Lime	2185 - 2255
Shale and Lime	2255 - 3237
Lime	3237 - 3440
Shale and Lime	3440 - 3560
Lime	3560 - 3890
Lime and Cherty Lime	3890 - 3973
Shale and Chert	3973 - 4046
Shale, Lime and Chert	4046 - 4060
Cherty Lime	4060 - 4079
Lime	4079 - 4090
Lime and Chert	4090 - 4107
Lime	4107 - 4135
Lime and Sand	4135 - 4170
Shale	4170 - 4174
Arbuckle Lime	4174 - 4188

RECEIVED
STATE CORPORATION COMMISSION

MAY 29 1964

CONSERVATION DIVISION
Wichita, Kansas

STATE OF KANSAS)
) SS
COUNTY OF SEDGWICK)

I hereby certify that the above information is true
and correct to the best of my knowledge.

[Signature]

Subscribed and sworn to before me this 23rd day of June, 1950.

[Signature]
Notary Public

My commission expires: 6-5-54

