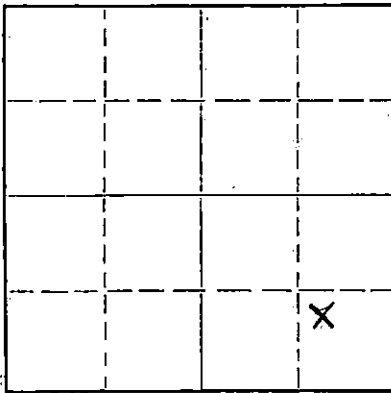


Give All Information Completely
Make Required Affidavit
Mail & Deliver Report to:
Conservation Division
State Corporation Commission
211 No. Broadway
Wichita, Kansas

WELL PLUGGING RECORD

NORTH

Locate well correctly on above
Section Plat.

Stafford County. Sec. 25 Twp. 24S Rge. 14W (E) (W)
Location as "NE/CNW/SW" or footage from lines NW SE SE
Lease Owner Shell Oil Company
Lease Name Tregellas Well No. # 1-W
Office Address 1200 1st Nat'l Bldg., Oklahoma City 2, Oklahoma
Character of Well (completed as Oil, Gas or Dry Hole) Softwater Disposal Well
Date well completed 19____
Application for plugging filed yes 19____
Application for plugging approved yes 19____
Plugging commenced 8-22-61 19____
Plugging completed 9-2-61 19____
Reason for abandonment of well or producing formation _____
If a producing well is abandoned, date of last production 19____
Was permission obtained from the Conservation Division or its agents before plugging was commenced? yes

Name of Conservation Agent who supervised plugging of this well Frank Broadfoot
Producing formation _____ Depth to top _____ Bottom _____ Total Depth of Well 4751' Feet
Show depth and thickness of all water, oil and gas formations.

OIL, GAS OR WATER RECORDS

CASING RECORD

FORMATION	CONTENT	FROM	TO	SIZE	PUT IN	PULLED OUT
				7"		2,031'

Describe in detail the manner in which the well was plugged, indicating where the mud fluid was placed and the method or methods used in introducing it into the hole. If cement or other plugs were used, state the character of same and depth placed, from _____ feet to _____ feet for each plug set.

Plugging commenced 8-22-61. Plugging completed 9-2-61.

Measured in to total depth.

Plugged off bottom: Sanded back to 1100' and dumped 5 sacks cement.

Worked and shot casing. Mixed 11 sacks salt gel & 16 sacks Bariod weight mud. Spotted oil @ 3140'. Pumped 20 sacks mud. Worked & shot casing. Loaded hole with water. Worked & shot 7" casing free @ 2,031'. Built rack and slide. Pulled and layed down casing.

Plugged well: Mudded hole up to 300' and set 10" rock bridge at 300'. Dumped 35 sacks cement. Mudded up to 30' and set 10" rock bridge at 30'. Capped the well with 15 sacks cement.

(If additional description is necessary, use BACK of this sheet)

Name of Plugging Contractor Forbes Casing Pulling, Inc.
Address Box 221 Great Bend, Kansas

STATE OF Kansas, COUNTY OF Barton, ss.
J. O. Forbes (employee of owner) or (owner or operator) of the above-described

well, being first duly sworn on oath, says: That I have knowledge of the facts, statements, and matters herein contained and the log of the above-described well as filed and that the same are true and correct. So help me God.

(Signature)

J. O. Forbes

Great Bend, Kansas

(Address)

SUBSCRIBED AND SWORN to before me this 5th day of September, 19 61

My commission expires December 8th, 1963

Kayann Jenkins

Notary Public.

WELL LOG

15-185-12990-0000

Shell Oil Company
G. P. Tregallas No. 1-W
Koelsch, Southeast Field

990' SL, 990' EL SE/4
Section 25-24S-14W
Stafford County, Kansas

Casing

10 3/4" - 32.75' set @ 825'
7" - 237' set @ 4265'

Cemented

600 Sacks
200 Sacks

Denth

0-90
90-185
185-550
550-823
823-860
860-1130
1130-1635
1635-1680
1680-1785
1785-2070
2070-2115
2115-3225
3225-3322
3322-3327
3327-3348
3348-3351
3351-3390
3390-3395
3395-3452
3452-3458
3458-3633
3633-3636
3636-3658
3658-3660
3660-3688
3688-3694
3694-3706
3706-3710
3710-3744
3744-3751
3751-3762
3762-3764
3764-3979
3979-4199
4199-4206
4206-4230
4230-4751

Formation

Surface clay and sand
Shale
Red bed and shale
Shale and red bed
Anhydrite
Shale and red bed
Shale
Salt
Shale and lime
Lime
Shale
Lime and shale
Lime
Shale
Lime
Shale
Lime
Shale
Lime
Shale
Lime
Shale
Lime
Shale
Lime
Shale
Lime
Shale
Lime
Shale
Lime
Chert
Sand
Chert
Dolomite

RECEIVED
STATE CORPORATION COMMISSION
JUL 20 1961
CONSERVATION DIVISION
Wichita, Kansas