


WELL PLUGGING RECORD

Give All Information Completely
Make Required Affidavit
Mail or Deliver Report to:
Conservation Division
State Corporation Commission
800 Bittling Building
Wichita, Kansas

NORTH

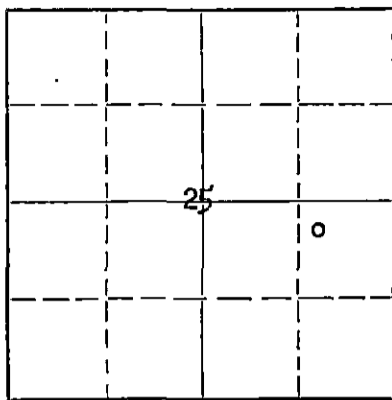

Locate well correctly on above
Section Plat

Stafford County. Sec. 25 Twp. 24S Rge. (E) 14(W)
Location as "NE/CNW%SW%" or footage from lines NW/NE/SE
Lease Owner Shell Oil Company
Lease Name H. A. Prescott Well No. 3
Office Address Box 714, Great Bend, Kansas
Character of Well (completed as Oil, Gas or Dry Hole) Oil
Date well completed November 14 1953
Application for plugging filed April 22 1959
Application for plugging approved April 23 1959
Plugging commenced April 27 1959
Plugging completed May 5 1959
Reason for abandonment of well or producing formation Oil Depleted

If a producing well is abandoned, date of last production April 21 1959
Was permission obtained from the Conservation Division or its agents before plugging was commenced? Yes

Name of Conservation Agent who supervised plugging of this well Mr. Frank Broadfoot
Producing formation Arbuckle Depth to top 4175 Bottom -- Total Depth of Well 4187 Feet
Show depth and thickness of all water, oil and gas formations.

OIL, GAS OR WATER RECORDS

CASING RECORD

| FORMATION | CONTENT | FROM | TO | SIZE | PUT IN | PULLED OUT |
|-----------|---------------------------------------|------|------|--------|--------|------------|
| Arbuckle | I.P. 1467 BO, no water 24 hours | 4176 | 4187 | 8-5/8" | 830' | None |
| | | | | 5-1/2" | 4176' | 2886' |
| | | | | | | |
| | | | | | | |
| | | | | | | |

Describe in detail the manner in which the well was plugged, indicating where the mud fluid was placed and the method or methods used in introducing it into the hole. If cement or other plugs were used, state the character of same and depth placed, from _____ feet to _____ feet for each plug set.

Filled hole with sand to 4170'. Dumped 5 sacks of cement to 4137. Mudded to 250', set rock bridge to 240 and dumped 20 sacks of cement to 178. Filled hole with mud to 40', set rock bridge to 30 and capped well with 10 sacks of cement to bottom of cellar.

(If additional description is necessary, use BACK of this sheet)

Name of Plugging Contractor Forbes Casing Billing Company
Address Box 221, Great Bend, Kansas

STATE OF Kansas, COUNTY OF Barton, ss.
A. W. Weber (employee of owner) of the above-described well, being first duly sworn on oath, says: That I have knowledge of the facts, statements, and matters herein contained and the log of the above-described well as filed and that the same are true and correct. So help me God.

(Signature) A W Weber
Box 714, Great Bend, Kansas (Address)

SUBSCRIBED AND SWORN to before me this 11th day of May, 1959

My commission expires January 28, 1961

L. Mont Byers, Jr. Notary Public.

PLUGGING
FILE SEC 25 T. 24 R. 14
BOOK PAGE 33 LINE 17

RECEIVED
STAT COMMISSION
MAY 16 1959
Wichita, Kansas

SHELL-H. A. PRESCOTT #3
 NW NE SE 25-24S-14W
 Koelsch, S.E. Field
 Stafford County, Kansas

Casing Record

8 5/8" cem 830 with 425 sax
 5 1/2" cem 4176 with 175 sax; top cement in
 annulus by Line Oil Well Service - 3404'

0 - 120 sand
 260 shale
 625 red bed
 822 red bed & shale
 856 anhydrite
 1100 red bed & shale
 1550 shale
 1730 salt & shale
 1780 shale & lime
 1890 lime
 1945 lime & shale
 2047 lime
 2335 lime & shale
 2390 lime
 2465 shale
 2750 shale & lime
 2830 shale
 3200 shale & lime
 3271 lime
 3297 lime & shale
 3306 lime, some chert
 3318 lime, shale streaks
 3333 lime
 3337 shale
 3379 lime, shale streaks
 3406 lime
 3412 shale
 3436 lime, shale streaks
 3442 shale
 3448 lime
 3458 shale
 3483 lime, shale streaks
 3572 shale, quartz grains
 3578 lime
 3601 shale
 3624 lime
 3646 lime, shale streaks
 3651 lime
 3671 lime, shale streaks
 3681 lime
 3723 lime, shale streaks
 3795 lime
 3805 shale
 3811 lime
 3836 lime, shale streaks
 3845 lime
 3859 lime, shale streaks
 3871 lime
 3893 shale
 3913 lime, shale streaks
 3928 shale, v.c. & quartz grains
 3994 shale, v.c. & chert
 4058 shale & lime streaks in chert

4118 chert
 4134 lime, streaks shale, some chert
 4148 shale, quartz grains, some shale
 4160 sand, shale streak
 4175 shale, quartz grains, streaks lime
 4187 dolomite T.D.

Formation Tops

Heebner 3432
 Toronto 3452
 Brown Lime 3570
 Lansing-Kansas City 3600
 Marmaton 3865
 Kinderhook 3935
 Viola 3992
 Simpson 4131
 Arbuckle 4175

RECEIVED
 STATE CORPORATION COMMISSION
 APR 23 1959
 CONSERVATION DIVISION
 WICHITA, KANSAS

PLUGGING

FILE SEC. 25 T. 24 R. 14W
 BOOK PAGE 33 LINE 17

LB. 4-22-59