


STATE OF KANSAS
STATE CORPORATION COMMISSION

WELL PLUGGING RECORD

Give All Information Completely
Make Required Affidavit
Mail or Deliver Report to
Conservation Division
State Corporation Comm.
245 North Water
Wichita, KS 67202

Stafford County. Sec. 25 Twp. 24S Rge. 14WEA#
Location as "NE/CNW $\frac{1}{4}$ SW $\frac{1}{4}$ " or footage from lines C-S/2 S/2 NE/4
Lease Owner W. L. Kirkman, Inc.
Lease Name Anderson Well No. 1
Office Address P. O. Box 18611, Wichita, Kansas 67207
Character of Well (Completed as Oil, Gas or Dry Hole) Dry Hole
Date Well completed November 29, 1978
Application for plugging filed Verbal Application 1978
Application for plugging approved Verbal Approval 1978
Plugging commenced November 29, 1978
Plugging completed November 29, 1978
Reason for abandonment of well or producing formation _____

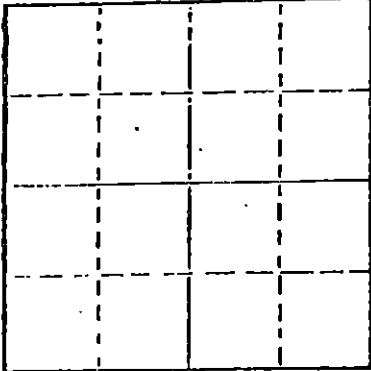

Locate well correctly on above Section Plot

If a producing well is abandoned, date of last production 1978

Was permission obtained from the Conservation Division or its agents before plugging was commenced? Yes

Name of Conservation Agent who supervised plugging of this well Wm. T. Owen
Producing formation _____ Depth to top _____ Bottom _____ Total Depth of Well 3,130'
Show depth and thickness of all water, oil and gas formations.

OIL, GAS OR WATER RECORDS

CASING RECORD

FORMATION	CONTENT	FROM	TO	SIZE	PUT IN	PULLED OUT
				8-5/8"	449'	None

Describe in detail the manner in which the well was plugged, indicating where the mud fluid was placed and the method or methods used in introducing it into the hold. If cement or other plugs were used, state the character of same and depth placed, from _____ feet to _____ feet for each plug set.

Filled hole with heavy rotary mud from 3,130 ft. (rotary total depth) to 450 ft. Set plug at 450 ft. and cemented with 50 sacks cement. Filled hole with heavy rotary mud from 450 ft. to 40 ft. Set solid plug at 40 ft. and cemented to cellar with 12 sacks cement, 3 sacks cement in rat hole.

Plugging operations accomplished utilizing Sun Oil Well cementing pump truck through 4 1/2 inch drill pipe.

RECEIVED
STATE CORPORATION COMMISSION

DEC 11 1978 12-11-78

(If additional description is necessary, use BACK of this sheet)

Name of Plugging Contractor Sun Oilwell Cementing, Inc.
Box 169, Great Bend, Kansas 67530

CONSERVATION DIVISION
Wichita, Kansas

STATE OF Kansas COUNTY OF Sedgwick, ss.
Dean Britting, Agent ~~Agent~~ of owner ~~XXXXXXXXXXXXXXXXXXXX~~

of the above-described well, being first duly sworn on oath, says: That I have knowledge of the facts, statements, and matters herein contained and the log of the above-described well as filed and that the same are true and correct. So help me God.

(Signature) Dean Britting
200 N. Main, Wichita, Kansas 67202
(Address)

SUBSCRIBED AND SWORN TO before me this 8th day of December, 1978

Elsie Willison
Elsie Willison - Notary Public.

My commission expires July 25, 1982



KANSAS DRILLERS LOG

COMPANY W. L. Kirkman, Inc.

SEC. 25 T. 24S R. 14W
LOC. C-S/2 S/2 NE/4

FARM Anderson

NO. 1

COUNTY Stafford

ROTARY TOTAL DEPTH 3,130'

COMM. November 24, 1978

COMP. November 29, 1978

CONTRACTOR H-30, Inc. (Rig #7)

ISSUED December 8, 1978

CASING

10 3/4"

8 5/8" Set at 449' cemented w/325 sxs cement

5 1/2"

4 1/2"

ELEVATION 1,943'K.B.

FIGURED INDICATE BOTTOM OF FORMATIONS

Sand and Shale	453'
Shale and Shells	1,055'
Shale	1,703'
Lime and Shale	1,956'
Shale and Lime	2,056'
Lime and Shale	3,130'
Rotary Total Depth	3,130'


I hereby certify the above and foregoing to be a true and correct log of the above described well as shown by the drilling reports.

H-30, Inc.

Dean Britting
Dean Britting

State of Kansas }
County of Sedgwick } SS:

Subscribed and Sworn to before me a Notary Public in and for said county and state this 8th day of December, 1978.

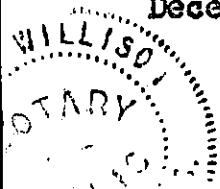

Elsie Willison
Elsie Willison - Notary Public

My Commission Expires:
July 25, 1982

RECEIVED
STATE CORPORATION COMMISSION
DEC 11 1978
CONSERVATION DIVISION
Wichita, Kansas