


Give All Information Completely
Make Required Affidavit
Mail or Deliver Report to:
Conservation Division
State Corporation Commission
800 Bitting Building
Wichita, Kansas

WELL PLUGGING RECORD

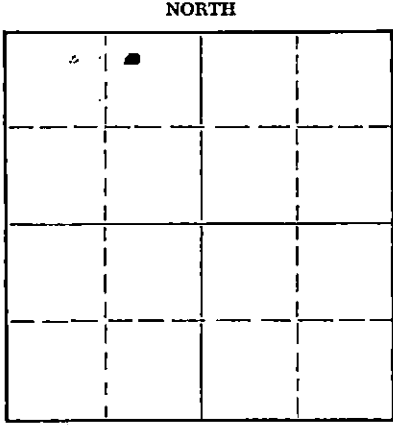

Locate well correctly on above Section Plat

Stafford County, Sec. 25 Twp. 24 Rge. 14 W (E) (W)
Location as "NE/CNW/SW" or footage from lines NW NE NW
Lease Owner Helmerich and Payne, Inc.
Lease Name Abbott Well No. 2
Office Address First National Bldg., Tulsa 3, Oklahoma
Character of Well (completed as Oil, Gas or Dry Hole) Oil
Date well completed Feb. 25, 1953 19
Application for plugging filed May 4, 1955 19
Application for plugging approved May 5, 1955 19
Plugging commenced May 16, 1955 19
Plugging completed May 17, 1955 19
Reason for abandonment of well or producing formation Dry

If a producing well is abandoned, date of last production April 17, 1955 19
Was permission obtained from the Conservation Division or its agents before plugging was commenced? Yes

Name of Conservation Agent who supervised plugging of this well Mr. Warren H. Horner
Producing formation Lansing-Kansas City Depth to top 3622' Bottom 3893' Total Depth of Well 4250' Feet
Show depth and thickness of all water, oil and gas formations.

OIL, GAS OR WATER RECORDS

CASING RECORD

FORMATION	CONTENT	FROM	TO	SIZE	PUT IN	PULLED OUT
Heebner Shale		3460'				
Brown Lime		3595				
Lansing-Kansas City		3622				

Describe in detail the manner in which the well was plugged, indicating where the mud fluid was placed and the method or methods used in introducing it into the hole. If cement or other plugs were used, state the character of same and depth placed, from _____ feet to _____ feet for each plug set.

Sanded hole to 3748' - Ran 5 sacks cement
Mudded hole to 380' - Set rock bridge - Ran 20 sacks cement
Mudded hole to 35' - Ran 10 sacks cement

(If additional description is necessary, use BACK of this sheet)

Name of Plugging Contractor R & D Casing Pulling Co.
Address P. O. Box 569, Ellinwood, Kansas

STATE OF Kansas, COUNTY OF Sedgwick, ss.
Nathan E. Clark (employee of owner) or (owner or operator) of the above-described well, being first duly sworn on oath, says: That I have knowledge of the facts, statements, and matters herein contained and the log of the above-described well as filed and that the same are true and correct. So help me God.

(Signature) Nathan E. Clark
821 Central Bldg., Wichita, Kansas
(Address)

SUBSCRIBED AND SWORN to before me this 21 day of May, 1955

My commission expires July 19, 1956

Michael Lindemann
Notary Public.

PLUGGING
FILE SEC 25 TWP 24 R 14 W
BOOK PAGE 116 LINE 38


RECEIVED
STATE CORPORATION COMMISSION
MAY 24 1955
5-24-55
CONSERVATION DIVISION
Wichita, Kansas

WELL LOG BUREAU—KANSAS GEOLOGICAL SOCIETY
508 East Murdock, Wichita, Kansas

Company: HELMERICH & PAYNE, INC.
Farm: Abbott No. 2

SEC. 25 T. 24 R. 14W
NW NE NW
2310' N of SL
1650' E of WL NW $\frac{1}{4}$
County Stafford
KANSAS

Total Depth. 3900'
Comm. 2-1-53 Comp. 2-16-53
Shot or Treated.
Contractor. Pool Bros. Inc.
Issued. 4-18-53

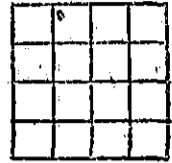

Elevation. 1944 DF

Production. State Pot. 30.24 Bbl .
46% water.

Figures Indicate Bottom of Formations.

sand	60
shale, sand	385
shale, red bed	700
red bed	750
shale	837
anhyd.	875
shale, shells	1475
salt, shale	1810
limo	1875
lime, shale	1990
sand, shale	2010
shale, with lime streaks	2175
limo	2200
limo, shale	3160
limo	3220
lime, shalo	3691
lime	3900
Total Depth	

Tops	
Heobnor	3460
Brown Lime	3595
Lansing	3622

3751-59 45 & acidized with 250 gals. 15% acid.

PLUGGING
FILE SEC 25 T 24 R 14W
BOOK PAGE 116 LINE 38

RECEIVED
REGISTRATION COMMISSION
MAY 5 1955
REGISTRATION DIVISION
Wichita, Kansas