
15-185-13018-0000

STATE OF KANSAS
STATE CORPORATION COMMISSION

Give All Information Completely
Make Required Affidavit
Mail or Deliver Report to:
Conservation Division
State Corporation Commission
800 Bitting Building
Wichita, Kansas

WELL PLUGGING RECORD

NORTH

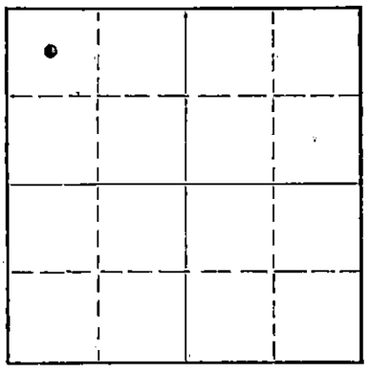

Locate well correctly on above Section Plat

Stafford County. Sec. 25 Twp. 24 S Rge. 14 (E) W (W)
Location as "NE/CNW¼SW¼" or footage from lines NW NW NW
Lease Owner Helmerich & Payne, Inc.
Lease Name Abbott Well No. 1
Office Address Box 255; Garden City, Kansas
Character of Well (completed as Oil, Gas or Dry Hole) Oil
Date well completed 19
Application for plugging filed 9/15 19 59
Application for plugging approved 9/15 (verbal) 19 59
Plugging commenced 9/15 19 59
Plugging completed 9/19 19 59
Reason for abandonment of well or producing formation Depletion of oil

If a producing well is abandoned, date of last production 19
Was permission obtained from the Conservation Division or its agents before plugging was commenced? Yes

Name of Conservation Agent who supervised plugging of this well Frank Broadfoot
Producing formation Depth to top Bottom Total Depth of Well 3930 Feet
Show depth and thickness of all water, oil and gas formations.

OIL, GAS OR WATER RECORDS — CASING RECORD

FORMATION	CONTENT	FROM	TO	SIZE	PUT IN	PULLED OUT
				8 5/8	245	None
				5 1/2	3813	2980

Describe in detail the manner in which the well was plugged, indicating where the mud fluid was placed and the method or methods used in introducing it into the hole. If cement or other plugs were used, state the character of same and depth placed, from feet to feet for each plug set.

Plugged back with sand from 3930' to 3740'. Mixed and dumped 5 sax cement from 3740' to 3700'. Pulled 5½" casing. Pumped in 20 sax gel mud. Put in plug. Pumped in 75 sax cement from 225' to base cellar. Pumped by Sun Cementing Co. 400# pumping pressure.

RECEIVED
STATE CORPORATION COMMISSION
OCT 2 1959
CONSERVATION DIVISION
Wichita, Kansas

(If additional description is necessary, use BACK of this sheet)

Name of Plugging Contractor Ace Pipe Pulling Co.
Address Box 304 Great Bend, Kansas

STATE OF Kansas, COUNTY OF Finney, ss.
T. E. Mort (employee of owner) or (~~owner or operator~~) of the above-described well, being first duly sworn on oath, says: That I have knowledge of the facts, statements, and matters herein contained and the log of the above-described well as filed and that the same are true and correct. So help me God.

(Signature) T. E. Mort

Box 255; Garden City, Kansas
(Address)

SUBSCRIBED AND SWORN TO before me this 1 day of October, 19 59

Russell Wells
Notary Public.

My commission expires 11/29/60

5-44N

15.185.13018.0000

KANSAS GEOLOGICAL SOCIETY
KANSAS WELL LOG BUREAU — KANSAS WELL SAMPLE BUREAU
KANSAS GEOLOGICAL SOCIETY BUILDING
508 EAST MURDOCK · WICHITA, KANSAS

COMPANY WHITE EAGLE OIL CO.

FARM Abbott NO 1

S 25 T 24 R 14W
LOC NW NW NW
2310 N SL 330' E WL

COUNTY Stafford

TOTAL DEPTH 3930'
COMM 10-19-52 COMP 11-1-52
SHOT OR TREATED
CONTRACTOR
ISSUED 1-3-53

CASING

20	XX 9 5/8"	241' w/250 sx cem.
15	8	
12	6	
13	5½	3812' w/150 sx cem.

ELEVATION 1947 DF

PRODUCTION 1351 Bbls.

FIGURES INDICATE BOTTOM OF FORMATIONS

gravel, sand	110
shale	160
sand	175
sand, shale	230
ree bed	840
anhydrite	865
shale, shells	1200
salt shale, shells	1440
shale, lime	1710
broken lime	1840
lime	1955
lime, shale	2105
lime	2360
lime, shale	3260
lime	3536
lime, shale	3597
lime	3930
Total Depth	

TOPS:

Heebner	3466
Brown lime	3597
Lansing	3624

Perforated: Lansing 3754-3766
80 holes & acidized w/3000 gals.