


Give All Information Completely
Make Required Affidavit
Mail or Deliver Report to:
Conservation Division
State Corporation Commission
800 Bitting Building
Wichita, Kansas

WELL PLUGGING RECORD
OR 15-009-05563-0000
FORMATION PLUGGING RECORD

Strike out upper line
when reporting plug-
ging off formations.

NORTH

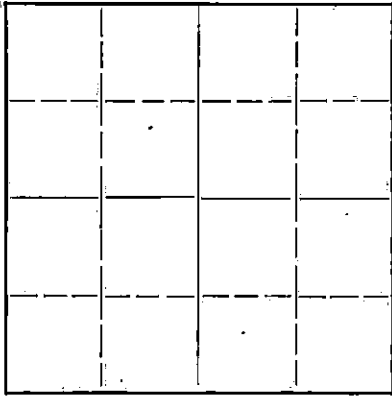

Locate well correctly on above
Section Plat

Barton County, Sec. 31 Twp. 16 Rge. 11 (W)

Location as "NE $\frac{1}{4}$ NW $\frac{1}{4}$ SW $\frac{1}{4}$ " or footage from lines NE NW SE

Lease Owner The Texas Company

Lease Name A. Janssen Well No. 2

Office Address 614 Bitting Bldg., Wichita, Kansas

Character of Well (completed as Oil, Gas or Dry Hole) Dry Hole

Date well completed January 22, 1943

Application for plugging filed January 22, 1943

Application for plugging approved January 22, 1943

Plugging commenced January 23, 1943

Plugging completed January 23, 1943

Reason for abandonment of well or producing formation Dry Hole

If a producing well is abandoned, date of last production 19

Was permission obtained from the Conservation Division or its agents before plugging was commenced? Yes

Name of Conservation Agent who supervised plugging of this well C. T. Alexander

Producing formation Depth to top Bottom Total Depth of Well 3373 Feet

Show depth and thickness of all water, oil and gas formations:

OIL, GAS OR WATER RECORDS


CASING RECORD

Formation	Content	From	To	Size	Put In	Pulled Out
				10-3/4"	373	None

Describe in detail the manner in which the well was plugged, indicating where the mud fluid was placed and the method or methods used in introducing it into the hold. If cement or other plugs were used, state the character of same and depth placed, from feet to feet for each plug set.

The hole was filled with mud from 3373 to 373' and a bridge set at 373' and cemented with 15 sacks cement to 328' and mud and bridge to 26' and cemented to 6' and filled with heavy mud to surface.

PLUGGING
FILE 38-3116-11A
BOOK PAGE 61 LINE 26

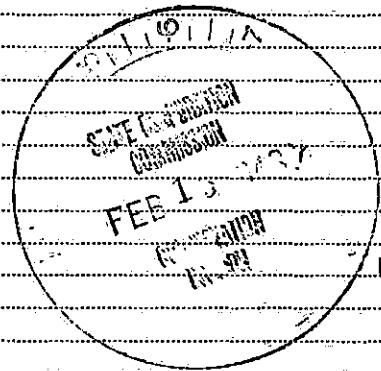

(If additional description is necessary, use BACK of this sheet)

Correspondence regarding this well should be addressed to The Texas Co., % M. C. Harrell
Address 614 Bitting Bldg., Wichita, Kansas

STATE OF KANSAS, COUNTY OF SEDGWICK, ss.

M. C. HARRELL

(employee of owner) or ~~owner~~

being first duly sworn on oath, says: That I have knowledge of the facts, statements, and matters herein contained and the log of the above-described well as filed and that the same are true and correct. So help me God.

(Signature)

The Texas Company
By M. C. Harrell
614 Bitting Bldg. Wichita, Kansas
(Address)

SUBSCRIBED AND SWORN to before me this 11th day of February, 1943

Velma Wrightman
Notary Public.

My commission expires Dec 20, 1944



LOG OF WELL

Form PO-214 Sht 1 (4-39) 10M

SHEET 1

OWNER The Texas Company DIVISION Oklahoma DATE MADE 2/11/43
 DISTRICT Kansas LEASE A. Janssen WELL NO. 2
 STATE Kansas COUNTY OR PARISH Barton TWP. 16S RANGE 11W SEC. 31
 LOCATION OF WELL NE NW SE
 COMMENCED RIGGING UP 1/7/43 COMMENCED DRILLING 1/8/43 COMPLETED DRILLING 1/22/43
 DAY DRILLER _____ NIGHT DRILLER _____ CONTRACTOR Helnrich & Payne Inc.
 CABLE FROM _____ TO _____ ROTARY FROM 0 TO 3373 COMPANY RIG No. _____
 TOTAL DEPTH 3373 MEASURED BY M. C. Harroll ELEVATION _____

CASING RECORD

SIZE	WEIGHT	PUT IN WELL		PULLED OUT		LOST IN WELL		SHOES		PACKERS			
		FEET	INS.	FEET	INS.	FEET	INS.	LENGTH	MAKE	KIND	LENGTH	SET AT	
<u>10-3/4"OD</u>	<u>32.75LW</u>	<u>373</u>											FT.
													FT.
													FT.
													FT.
													FT.
													FT.
													FT.
													FT.


10-3/4" cemented w/ 275 sacks cement

WAS CASING CEMENTED? _____ IF SO, HOW MANY SACKS OF CEMENT USED? _____
 LINER: STATE SIZE AND WEIGHT _____ WHERE SET _____ FT. AND INS. BLANK _____ FT. AND INS. PERFORATED _____
 HOW PUT TOGETHER _____ COUPLING _____ FLUSH-JOINT _____ INSERTED _____
 REMARKS: _____

EQUIPMENT RECORD

TUBING				SUCKER RODS			PUMPING OUTFIT
SIZE	WEIGHT	FEET	INS.	FEET	INS.	SIZE AND KIND	DESCRIPTION, KIND, SIZE, ETC.
							PLUGGING FILE SEC <u>31 16-91-10</u> BOOK PAGE <u>61</u> LINE <u>26</u>

FLOWING, PUMPING, GASSER OR DRY Dry PRODUCTION FIRST 24 HOURS _____ PRODUCTION SETTLED _____
 IF GAS WELL, OPEN FLOW CAPACITY _____ SHUT IN PRESSURE _____ ROCK PRESSURE _____
 KIND OF SHOT _____ SIZE OF SHOT, QUARTS _____
 NUMBER OF SHELLS _____ SIZE OF SHELLS _____ INCHES, DIAMETER _____
 LENGTH OF SHELLS _____ FEET _____ INCHES _____ TOP OF SHOT _____
 BOTTOM OF SHOT _____ ANCHOR _____ WELL BRIDGED TO _____
 TOTAL DEPTH OF WELL _____ NUMBER OF SHOT _____ PRODUCTION BEFORE SHOT _____ BBLs. PER DAY _____
 PRODUCTION AFTER SHOT _____ BBLs. PER DAY. SHOT FURNISHED BY _____
 NAME OF SHOOTER _____ SHOT INSPECTED _____ BY _____ (COMPANY EMPLOYEE)
 COMMENCED DRILLING DEEPER _____ COMPLETED _____ DRILLING DEEPER _____
 TOTAL DEPTH _____ PRODUCTION FIRST 24 HOURS _____ PRODUCTION SETTLED _____
 REMARKS: D & A Plugged well 1/23/43

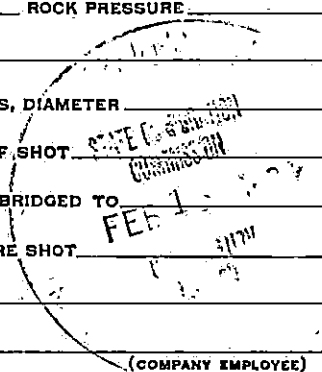

NOTE: IF WELL WAS DRY, STATE UNDER REMARKS, WHEN, HOW, AND BY WHOM PLUGGED.
 STATE UNDER REMARKS ANYTHING OF INTEREST NOT COVERED IN LOG.
 IF THE SPACE PROVIDED FOR REMARKS IS NOT SUFFICIENT WRITE ON BOTTOM OF LAST SHEET OF LOG.

LOG OF WELL

SHEET NO. _____

District **Kansas**

Owner **The Texas Company** Farm **A. Janssen**

Well No. **2**

FORMATION		AMOUNT	COLOR	HARD OR SOFT	DEPTH CORES TAKEN	REMARKS
Clay & Shells	225	225				
Sand	295	70				
Shale & Shells	745	450				
Anhydrite	773	28				
Shale & Shells	1250	477				
Shale	1450	200				
Shale & Lime	1625	175				
Lime & Shale-sdy.	1785	160				
Shale & Lime	1810	25				
Broken Lime	1960	150				
Lime & Sandy Lime	2040	80				
Lime & Shale	2675	635				
Lime & Shale	2696	21				
Sticky Shale	2713	17				
Lime - Cherty	2762	49				
Lime	2853	91				
Lime - Hard	2891	38				
Lime	2946	55				
Shale & Lime	3010	64				
Sand	3024	14				
Lime & Shale	3064	40				
Lime	3092	28				
Lime	3176	84				
Lime (Soft)	3202	26				
Lime	3343	141				
Conglomerate Sdy. & Cherty	3373	30				
Total Depth	3373					

FILE NO. 31 16 11W
BOOK PAGE 61 26

FEB 1 1911