


Give All Information Completely
Make Required Affidavit
Mail or Deliver Report to:
Conservation Division
State Corporation Commission
211 No. Broadway
Wichita, Kansas

WELL PLUGGING RECORD

Hodgeman County, Sec. 21 Twp. 22S Rge. 25W (E) (W)

Location as "NE/CNW&SW" or footage from lines c SE SW
Lease Owner Jennings & Clogg
Lease Name Coleman Well No. 1
Office Address 662 1st Natl. Bldg., Oklahoma City 2, Okla.
Character of Well (completed as Oil, Gas or Dry Hole) Dry Hole
Date well completed December 28 19 62
Application for plugging filed December 28 19 62
Application for plugging approved December 28 19 62
Plugging commenced December 28 19 62
Plugging completed December 28 19 62
Reason for abandonment of well or producing formation Dry Hole

NORTH

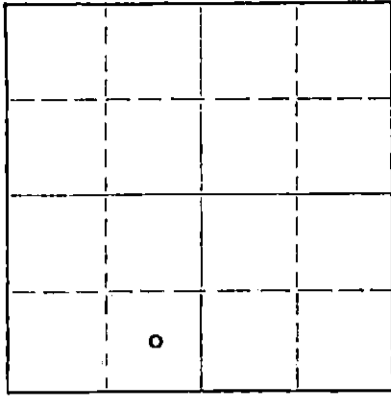

Locate well correctly on above Section Plat

If a producing well is abandoned, date of last production _____ 19____
Was permission obtained from the Conservation Division or its agents before plugging was commenced? yes

Name of Conservation Agent who supervised plugging of this well Hugh Scott, Box 1223, Liberal, Kansas
Producing formation _____ Depth to top _____ Bottom _____ Total Depth of Well _____ Feet
Show depth and thickness of all water, oil and gas formations.

OIL, GAS OR WATER RECORDS

CASING RECORD

FORMATION	CONTENT	FROM	TO	SIZE	PUT IN	PULLED OUT
		0	272	8 5/8"	272	None

Describe in detail the manner in which the well was plugged, indicating where the mud fluid was placed and the method or methods used in introducing it into the hole. If cement or other plugs were used, state the character of same and depth placed, from _____ feet to _____ feet for each plug set.
Set Plug @ 270' 30 sacks cement & 1/2 sacks hulls
Plug @ 35' 10 sacks cement & 1/2 sacks hulls

1-4-63

THE CORPORATION

JAN 4 1963

CONSERVATION DIVISION
WICHITA, KANSAS

(If additional description is necessary, use BACK of this sheet)

Name of Plugging Contractor Hellar Drilling Company, Inc.
Address 1014 Union Center, Wichita 2, Kansas

STATE OF Kansas COUNTY OF Sedgwick, ss.
D. L. Hellar, Pres. of Hellar Drlg. Co. Inc. (employee of owner) or (owner or operator) of the above-described well, being first duly sworn on oath, says: That I have knowledge of the facts, statements, and matters herein contained and the log of the above-described well as filed and that the same are true and correct. So help me God.

(Signature) D. L. Hellar D.L. Hellar, Pres.
1014 Union Center, Wichita 2, Kansas
(Address)

SUBSCRIBED AND SWORN TO before me this 31st day of December, 19 62

My commission expires March 25, 1964.

Catherine Darcey
Notary Public - Catherine Darcey Notary Public.



DRILLER'S LOG

COMPANY: Jennings & Clogg
 CONTRACTOR: Hellar Drilling Company, Inc.
 LEASE: #1 Coleman
 LOCATION: c. SE SW 21-22S-25W
 Hodgeman County, Kansas
 COMMENCED: December 9, 1962
 COMPLETED: December 28, 1962
 CASING: Set 8 5/8" surface casing @ 272'/200 sacks cement

0-190	Shale-Post rock-sand
190-271	Shale-sand rock
271-1569	Shale-sand
1569-1714	Red Beds & shale
1714-1720	Anhydrite
1720-2009	Shale & Shells
2009-2421	Shale-Lime
2421-2659	Lime-Shale
2659-2742	Ft. Riley
2742-2800	Lime
2800-2890	Ft. Riley section
2890-3355	Lime-Shale
3355-3532	Shale-Lime
3532-3721	Lime-Shale
3721-3830	Lime-chalky-Shale
3830-3986	Lime-Shale
3986-4065	Lime, Clark-shale
4065-4177	Lime-Lsg. K.C.
4177-4241	K.C. Lime
4241-4268	Lime
4268-4327	Lime - K. C.
4327-4372	Lime
4372-4408	Lime (sand & shale)
4408-4679	Lime & Shale
4679-4715	Lime-Shale-Chert
4715-4730	Lime & Chert
4730-4758	Lime-Shale-Chert
4758	Rotary Total Depth
	Dry & Abandoned

STATE OF KANSAS
 CONSERVATION DIV.
 Wichita, Kansas
 JAN 4 1963

STATE OF KANSAS)
) SS
 COUNTY OF SEDGWICK)

I, D. L. Hellar, do hereby certify that the above and foregoing is a true and correct copy of the log of the #1 Coleman, located in c SE SW Section 21-22S-25W, Hodgeman County, Kansas, as reflected by the files of the Hellar Drilling Company, Inc.

HELLAR DRILLING COMPANY, INC.

By D. L. Hellar
 D. L. Hellar - President

Subscribed and sworn to before me, a Notary Public, in and for Sedgwick County, Kansas, this 31st day of December, 1962.

My Commission Expires: March 25, 1964.

Catherine Dorcey
 Notary Public - Catherine Dorcey