


WELL PLUGGING RECORD

Give All Information Completely
Make Required Affidavit
Mail or Deliver Return to:
Conservation Division
State Corporation Commission
211 No. Broadway
Wichita, Kansas

Hodgeman County, Sec. 21 Twp. 22S Rge. 25W (E) (W)
Location as "NE/CNWxSWx" or footage from lines 974.6' FEL & 330' FSL SE/4
Lease Owner Kewanee Oil Company
Lease Name Coleman Well No. 1
Office Address Box 360, Hoisington, Kansas
Character of Well (completed as Oil, Gas or Dry Hole) Dry Hole
Date well completed March 19, 19 57
Application for plugging filed March 19, 19 57
Application for plugging approved File 1-9 March 19, 19 57
Plugging commenced March 19, 19 57
Plugging completed March 19, 19 57
Reason for abandonment of well or producing formation Dry Hole

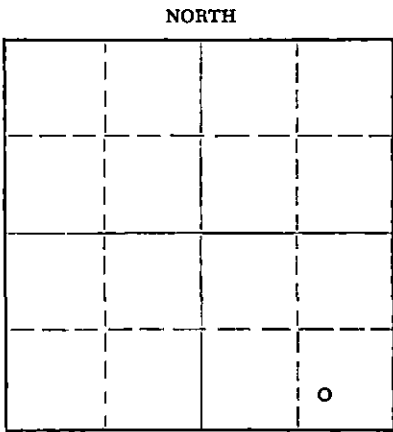

Locate well correctly on above Section Plat

If a producing well is abandoned, date of last production _____ 19____
Was permission obtained from the Conservation Division or its agents before plugging was commenced? Yes - permission from Mr. Rives 3-19-57 - verbal.

Name of Conservation Agent who supervised plugging of this well Mr. M. A. Rives, Box 8, Pratt, Kansas
Producing formation _____ Depth to top _____ Bottom _____ Total Depth of Well 4770 Feet
Show depth and thickness of all water, oil and gas formations.

OIL, GAS OR WATER RECORDS

CASING RECORD

FORMATION	CONTENT	FROM	TO	SIZE	PUT IN	PULLED OUT
				8-5/8"	563'	None
Heebner	Dry	3925				
Toronto	Dry	3946				
Douglas	Dry	3970				
Lansing-Kansas City	Dry	3980				
Marmaton	Dry	4408				
Basal Penn. Congl.	Dry	4616				
Mississippi	Dry	4628	4770 T.D.			

Describe in detail the manner in which the well was plugged, indicating where the mud fluid was placed and the method or methods used in introducing it into the hole. If cement or other plugs were used, state the character of same and depth placed, from _____ feet to _____ feet for each plug set.

Filled hole with mud to 550'.
Halliburton plug at 550'.
20 sacks cement on top of plug from 550' to 488.50'
Mud from 488.50' to 35'.
Halliburton plug at 35'.
Spotted 1/2 sack cottonseed hulls on top of plug.
Filled to top of casing w/cement.
Casing completely filled to surface.

3-30-57

RECEIVED
STATE CORPORATION COMMISSION

MAR 30 1957

CONSERVATION DIVISION
Wichita, Kansas

(If additional description is necessary, use BACK of this sheet)

Name of Plugging Contractor Graham-Michaelis Drilling Company
Address Wichita, Kansas.

STATE OF Kansas, COUNTY OF Barton, ss.
Peter Blanda (employee of owner) or (owner or operator) of the above-described well, being first duly sworn on oath, says: That I have knowledge of the facts, statements, and matters herein contained and the log of the above-described well as filed and that the same are true and correct. So help me God.

(Signature) Peter Blanda

P. O. Box 360, Hoisington, Kansas.
(Address)

SUBSCRIBED AND SWORN TO before me this 28th day of March, 19 57

Lucille W. Dulla
Notary Public.

My commission expires September 21, 1957

PLUGGING
FILE SEC 21 T. 22 R. 25W
BOOK PAGE 1 LINE 9

COLEMAN #1

Well Record

Location: SW SE SE Sec. 21-22-25W
 Hodgeman County, Kansas
 Commenced: March 3, 1957
 Completed: March 19, 1957
 (rotary)

Operator: Kewanee Oil Company
 Box 360
 Hoisington, Kansas

Contractor: Graham-Michaelis Drilling Co.,
 211 North Broadway
 Wichita, Kansas

Casing Record: 8 5/8" @563# W/320 sacks cement

LOG

Sand & Clay	83
Shale & Sand	557
Blue Shale	565
Shale	848
Red Bed-Shale	1110
Anhydrite	1135
Shale & Shells	2075
Shale & Lime	2612
Lime	2930
Lime & Shale	3375
Shale & Lime	3455
Lime-Shale	4005
Lime	4620
Core #1	4624
Core #2	4632
Lime & Chert	4676
Lime	4700, RTD.

STATE OF KANSAS)
) ss.
 COUNTY OF SEDGWICK)

The undersigned, GRAHAM-MICHAELIS DRILLING COMPANY, hereby certifies that the above log is a true and correct log of the formation encountered in drilling the above well as reflected by the Daily Drilling Report.

GRAHAM-MICHAELIS DRILLING CO.,

By John L. James
 John L. James, Geologist

RECEIVED
 STATE CORPORATION COMMISSION

MAR 29 1957

CONSERVATION DIVISION
 Wichita, Kansas

Subscribed and sworn to before me
 this ~~XXXXXXXXXXXXXXXXXXXX~~ 1957
 28th day of March,

V. D. Grier
 V. D. Grier, Notary Public

My commission expires: 1/7/61.

PLUGGING
 FILE SEC. 21 T. 22 R. 25W
 BOOK PAGE 1 LINE 9