


WELL PLUGGING RECORD

Give All Information Completely
Make Required Affidavit
Mail or Deliver Report to:
Conservation Division
State Corporation Commission
212 North Market, Insurance Bldg.
Wichita, Kansas

NORTH

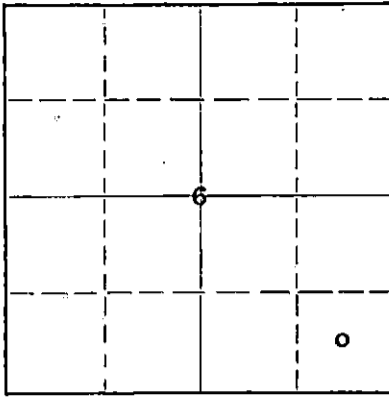

Locate well correctly on above
Section Plat

Hodgeman County. Sec. 6 Twp. 22S Rge. 25W (E) (W)
Location as "NE/CNW&SW&" or footage from lines C SE SE
Lease Owner Stelbar Oil Corporation, Inc.
Lease Name Hendrickson Well No. 1
Office Address 310 Petroleum Building, Wichita, Kansas
Character of Well (completed as Oil, Gas or Dry Hole) Dry Hole
Date well completed June 3, 19 61
Application for plugging filed June 3, 19 61
Application for plugging approved June 3, 19 61
Plugging commenced June 3, 19 61
Plugging completed June 3, 19 61
Reason for abandonment of well or producing formation Dry Hole

If a producing well is abandoned, date of last production _____ 19____
Was permission obtained from the Conservation Division or its agents before plugging was commenced? Yes

Name of Conservation Agent who supervised plugging of this well Frank Broadfoot
Producing formation _____ Depth to top _____ Bottom _____ Total Depth of Well 4624 Feet
Show depth and thickness of all water, oil and gas formations.

OIL, GAS OR WATER RECORDS

CASING RECORD

FORMATION	CONTENT	FROM	TO	SIZE	PUT IN	PULLED OUT
		0	229'	8 5/8"	254.49'	None

Describe in detail the manner in which the well was plugged, indicating where the mud fluid was placed and the method or methods used in introducing it into the hole. If cement or other plugs were used, state the character of same and depth placed, from _____ feet to _____ feet for each plug set.

Filled hole with mud to 200'. Set bottom plug with 1/2 sack hulls and 20 sacks cement. Filled hole with mud to 35'. Set top plug with 1/2 sack hulls and 10 sacks cement.

RECEIVED
STATE CORPORATION COMMISSION

JUN 12 1961 6-12-61

CONSERVATION DIVISION
Wichita, Kansas

(If additional description is necessary, use BACK of this sheet)
Name of Plugging Contractor Hellar Drilling Company, Inc.
Address 1014 Union Center, Wichita, Kansas

STATE OF KANSAS COUNTY OF SEDGWICK ss.
D.L. Hellar, President Hellar Drilling Co., drilling contractor of the above-described well, being first duly sworn on oath, says: That I have knowledge of the facts, statements, and matters herein contained and the log of the above-described well as filed and that the same are true and correct. So help me God.

(Signature) D.L. Hellar
D. L. Hellar
1014 Union Center, Wichita, Kansas
(Address)

SUBSCRIBED AND SWORN TO before me this 9th day of June, 19 61

Wanda Lou Buech
Notary Public.

My commission expires March 6, 1965.

DRILLER'S WELL LOG

OWNER:	Stelbar Oil Corporation, Inc.
CONTRACTOR:	Hellar Drilling Company, Inc.
LEASE:	Hendrickson #1
LOCATION:	C SE SE, Section 6-22S-25W Hodgeman County, Kansas
COMMENCED:	May 17, 1961
COMPLETED:	June 3, 1961
CASING:	Set 8 5/8" surface casing @ 229' w/125 sacks cement

0 - 231	Surface sand
231 - 1615	Shale
1615 - 1830	Shale & shells
1830 - 2322	Salt section
2322 - 2402	Lime & shale
2402 - 2538	Ft. Riley
2538 - 3906	Lime & shale
3906 - 3954	Lime
3954 - 4243	Lansing-Kansas City
4243 - 4552	Lime
4552 - 4624	Mississippian
4624	Rotary Total Depth
	D & A

RECEIVED
STATE CORPORATION COMMISSION
JUL
CONSERVATION DIVISION
Wichita, Kansas

STATE OF KANSAS)
) SS:
COUNTY OF SEDGWICK)

I, D. L. Hellar, do hereby certify that the above and foregoing is a true and correct copy of the log of the HENDRICKSON #1, located in the C SE SE, of Section 6-22S-25W, Hodgeman County, Kansas as reflected by the files of the Hellar Drilling Company, Inc.

HELLAR DRILLING COMPANY, INC.

BY: *D. L. Hellar*
D. L. Hellar, President

Subscribed and sworn to before me, a Notary Public, in and for Sedgwick County, Kansas this 9th day of June, 1961.

Wanda Lou Bruce
Notary Public

My commission expires March 6, 1965.