


STATE OF KANSAS
STATE CORPORATION COMMISSION

Form CP-4

Give All Information Completely
Make Required Affidavit
Mail or Deliver Report to:
Conservation Division
State Corporation Commission
211 No. Broadway
Wichita, Kansas

WELL PLUGGING RECORD

NORTH

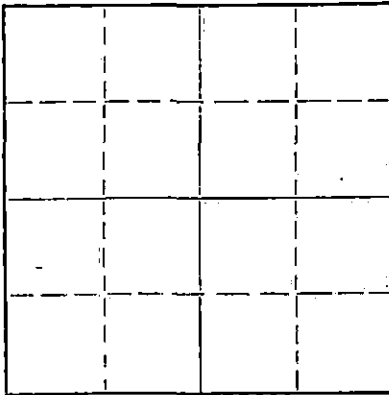

Locate well correctly on above
Section Plat

Hodgeman County. Sec. 23 Twp. 22 Rge. (E) 25 (W)

Location as "NE/CNW/SW" or footage from lines C SW NE

Lease Owner Pickrell Drilling Company

Lease Name Kellogg No. 1

Well No.

Office Address 705 4th National Bank Building, Wichita, Kansas

Character of Well (completed as Oil, Gas or Dry Hole)

Date well completed March 20, 19 65

Application for plugging filed March 20, 19 65

Application for plugging approved March 20, 19 65

Plugging commenced March 20, 19 65

Plugging completed March 20, 19 65

Reason for abandonment of well or producing formation Dry Hole

If a producing well is abandoned, date of last production 19

Was permission obtained from the Conservation Division or its agents before plugging was commenced? Yes

Name of Conservation Agent who supervised plugging of this well Hugh E. Scott

Producing formation Depth to top Bottom Total Depth of Well 4698 Feet

Show depth and thickness of all water, oil and gas formations.

OIL, GAS OR WATER RECORDS

CASING RECORD

FORMATION	CONTENT	FROM	TO	SIZE	PUT IN	PULLED OUT
				8 5/8	227'	None

Describe in detail the manner in which the well was plugged, indicating where the mud fluid was placed and the method or methods used in introducing it into the hole. If cement or other plugs were used, state the character of same and depth placed, from feet to feet for each plug set.

Heavy mud to 230', set plug, cemented with

25 sacks cement. Heavy mud to 45', set plug.

Cemented with 10 sacks cement to bottom of

cellar. Plugged rat hole with 2 sacks cement.

RECEIVED
STATE CORPORATION COMMISSION

APR 6 1965

CONSERVATION DIVISION
Wichita, Kansas

4-6-65

(If additional description is necessary, use BACK of this sheet)

Name of Plugging Contractor Pickrell Drilling Company

Address 705 4th National Bank Building, Wichita, Kansas

STATE OF KANSAS, COUNTY OF SEDGWICK, ss.
C. W. SEBITS

(Signature of owner or operator) of the above-described well, being first duly sworn on oath, says: That I have knowledge of the facts, statements, and matters herein contained and the log of the above-described well as filed and that the same are true and correct. So help me God.

(Signature)

C. W. Sebits
705 4th National Bank Bldg, Wichita, Kansas
(Address)

SUBSCRIBED AND SWORN TO before me this 24th day of March, 19 65

My commission expires

June 21, 1966

Notary Public.

ROTARY DRILLING LOG

COMPANY: PICKRELL DRILLING COMPANY
705 4th Natl Bank Building
Wichita, Kansas

Rotary Drilling Commenced 3--6-65

Rotary Drilling Completed 3-20-65

LOCATION: KELLOGG No. 1, C SW NE Section 23-22-25W, Hodgeman County, Kansas.

CONTRACTOR: PICKRELL DRILLING COMPANY
Wichita, Kansas

CASING RECORD: (10 jts) 8 5/8" surface casing set at 277' cemented with 165 sacks cement. Circulated. Completed 7:00 P.M. March 6, 1965. D & A, no oil string run.

LOG

(Figures indicate bottom of formation — measurements from top of rotary bushing.)

40	Top Soil & Sand	C. F. S.
70	Clay	4525
650	Shale & Shells	4630
830	Shale	4640
1069	Red Beds	4650
1110	Blaine	4660
1200	Shale & Shells	4670
1225	Sand	4675
1670	Shale & Shells	4698
1700	Anhydrite	
2190	Shale & Shells	
2505	Lime & Shale	Slope Test
2825	Lime	2800
2905	Lime & Shale	3300
3100	Lime	3800
3830	Shale & Lime	4300
4490	Lime	
4580q	Lime & Shale	S. I. M.
4610	Chert, Lime & Shale	2689
4640	Chert & Lime	4026
4675	Lime	4344
4698	Lime - Mississippian & RPD	

RECEIVED
STATE CORPORATION COMMISSION

APR 6 1965

CONSERVATION DIVISION
Wichita, Kansas

The undersigned, C. W. SEBITS, Attorney-in-Fact for PICKRELL DRILLING COMPANY, hereby certifies in behalf of said Company, that the above is a true and correct log of the formation encountered in drilling the above well as reflected by the Daily Drilling Reports.

PICKRELL DRILLING COMPANY

By C. W. SEBITS, Attorney-in-Fact

STATE OF KANSAS }
COUNTY OF SEDGWICK } ss.:

On this 24th day of March, 19 65, before me the undersigned, a Notary Public, in and for the County and State aforesaid, personally appeared C. W. SEBITS, to me known to be the identical person who subscribed the name of PICKRELL DRILLING COMPANY to the foregoing instrument as its Attorney-in-Fact and acknowledged to me that he executed the same as his free and voluntary act and deed, and as the free and voluntary act and deed of such company, for the uses and purposes therein set forth.

Given under my hand and seal of office the day and year last above written.

My commission expires: June 21, 1966

Maxine Blackman
Maxine Blackman, Notary Public