


STATE OF KANSAS
 STATE CORPORATION COMMISSION
 CONSERVATION DIVISION
 P. O. BOX 17027
 WICHITA, KANSAS 67217

FORM CP-4

WELL PLUGGING RECORD

Hodgeman County. Sec. 23 Twp. 22S Rge. (E)25W(W)
 Location as "NE/CNW/SW" or footage from lines C/NW/SW
 Lease Owner Kewanee Oil Company
 Lease Name Schmitt Well No. 3
 Office Address P. O. Box 2093, Wichita, Kansas 67201
 Character of Well (completed as Oil, Gas or Dry Hole) Dry Hole
 Date well completed 4-9-1976
 Application for plugging filed 4-20-1976
 Application for plugging approved (Verbal) 4-9-1976
 Plugging commenced 4-9-1976
 Plugging completed 4-10-1976
 Reason for abandonment of well or producing formation Dry Hole

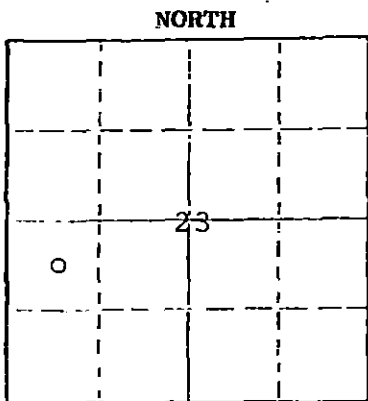

Locate well correctly on above Section Plat

If a producing well is abandoned, date of last production --- 19---
 Was permission obtained from the Conservation Division or its agents before plugging was commenced? Yes

Name of Conservation Agent who supervised plugging of this well Mr. Clarence Thomas, Garden City, Ks.
 Producing formation _____ Depth to top _____ Bottom _____ Total Depth of Well 4700 Feet
 Show depth and thickness of all water, oil and gas formations.

OIL, GAS OR WATER RECORDS				CASING RECORD		
FORMATION	CONTENT	FROM	TO	SIZE	PUT IN	PULLED OUT
Kansas City	Dry	3975		8-5/8"	558'	None
Base K.C.	"	4386				
Mississippi	"	4634				

Describe in detail the manner in which the well was plugged, indicating where the mud fluid was placed and the method or methods used in introducing it into the hole. If cement or other plugs were used, state the character of same and depth placed, from _____ feet to _____ feet for each plug set.

Plugged w/ 100 sacks 50-50 Pozmix, 6% Gel as follows:
 45 sacks @ 900', 35 sacks @ 500', 15 sacks from 40'
 to surface and 5 sacks in rat hole.

RECEIVED
 STATE CORPORATION COMMISSION

APR 28 1976

4-28-76

(If additional description is necessary, use BACK of this sheet)
 Name of Plugging Contractor Gabbert Jones Drilling Co. CONSERVATION DIVISION
 Address Wichita, Kansas Wichita, Kansas

STATE OF Kansas COUNTY OF Sedgwick, ss.
C. W. Mosier (employee of owner) or (owner/owner's agent) of the above-described

well, being first duly sworn on oath, says: That I have knowledge of the facts, statements, and matters herein contained and the log of the above-described well as filed and that the same are true and correct. So help me, God.

(Signature) [Signature]

P. O. Box 2093, Wichita, Kansas 67201
 (Address)

Subscribed and Sworn to before me this 27th day of April, 1976

My Commission expires 8-10-79

[Signature]
 Billie Oden
 Notary Public.

