


WELL PLUGGING RECORD

Give All Information Completely
Make Required Affidavit
Mail or Deliver Report to:
Conservation Division
State Corporation Commission
800 Bitting Building
Wichita, Kansas

NORTH

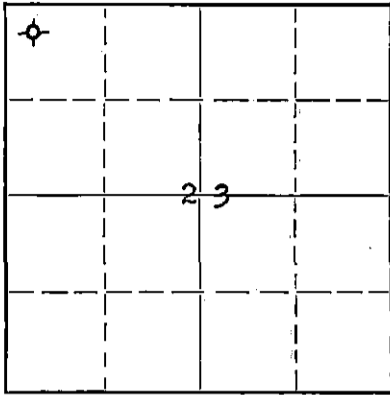

Locate well correctly on above
Section Flat

Hodgeman County. Sec. 23 Twp. 22S Rge. 25W (E) (W)
Location as "NE/CNW $\frac{1}{4}$ SW $\frac{1}{4}$ " or footage from lines NW NW NW
Lease Owner W. J. Coppinger
Lease Name Schmitt Well No. 1
Office Address 320 Union Nat'l Bank Bldg. Wichita, Kansas
Character of Well (completed as Oil, Gas or Dry Hole) Dry Hole
Date well completed April 1 19 52
Application for plugging filed April 2 19 52
Application for plugging approved April 3 19 52
Plugging commenced April 1 19 52
Plugging completed April 1 19 52
Reason for abandonment of well or producing formation Dry Hole

If a producing well is abandoned, date of last production 19
Was permission obtained from the Conservation Division or its agents before plugging was commenced? yes

Name of Conservation Agent who supervised plugging of this well M. A. Rives
Producing formation Depth to top Bottom Total Depth of Well 5186 Feet
Show depth and thickness of all water, oil and gas formations.

OIL, GAS OR WATER RECORDS

CASING RECORD

Formation	Content	From	To	Size	Put In	Pulled Out

Describe in detail the manner in which the well was plugged, indicating where the mud fluid was placed and the method or methods used in introducing it into the hole. If cement or other plugs were used, state the character of same and depth placed, from feet to feet for each plug set.

Filled hole with mud laden fluid to 270'.
Pushed plug to 270' and cemented with 20 sacks cement.
Filled hole with mud to 35'.
Pushed plug to 35' and cemented with 10 sacks cement.

(If additional description is necessary, use BACK of this sheet)

Name of Plugging Contractor W. J. Coppinger
Address 320 Union Nat'l Bank Bldg.
Wichita, Kansas

STATE OF Kansas, COUNTY OF Sedgwick, ss.
A. J. Carter (employee of owner) of the above-described well,
being first duly sworn on oath, says: That I have knowledge of the facts, statements, and matters herein contained and the log of the above-described well as filed and that the same are true and correct. So help me God.

(Signature) A. J. Carter
(Address)

SUBSCRIBED AND SWORN to before me this 4th day of April, 19 52.

My commission expires April 18, 1955.

23-8390-s 6-51-20M

PLUGGING
FILE SEC 23 T 22 R 25
BOOK PAGE 6 LINE 27

4-5-52

Notary Public.

DRILLERS LOG

Operator: W. J. Coppinger
 Contractor: W. J. Coppinger

SCHMITT #1
 NW 1/4 23-223-25W
 Hodgeman County, Kansas

Casing Record:
 8 5/8" at 125' with 225 sacks cement.

Clay	100
Sand & Shale	290
Shells & Shale	425
Shale & Red Bed	545
Shells & Shale	950
Red Bed	1000
Shale & Red Bed	1200
Sandy Red Bed	1400
Shale & Shells	1460
Red Bed, Shale & Shells	1682
Anhydrite	1717
Shale & Shells	1770
Shale	1900
Lime & Shale	1978
Shells & Shale	2390
Lime & Shale	2436
Shale & Shells	2475
Lime & Shale	2640
Lime	2665
Shale & Lime	3634
Lime	3678
Lime & Shale	3792
Lime	3800
Heebner Shale	3849
Lime	3954
Lime & Chert	3997
Lime	4070
Lime & Chert	4107
Lime	4143
Lime & Chert	4168
Lime	4485
Lime & Shale	4600
Lime & Chert	4620
Shale & Chert	4626
Mississippian Chert	4640
Lime & Shale	4650
Lime, Shale & Chert	4658
Lime & Shale	4753
Cherty Lime	4860
Chert, Lime & Shale	4880
Chert & Lime	4905
Cherty Lime	4929
Lime	4960
Lime & Chert	5025
Cherty Lime	5044
Lime & Chert	5135
Lime & Shale	5167
Lime, Shale & Chert	5186

TOBS:

T Anhydrite	1662
T Topoka	3564
T Heebner	3798
T Kansas City	3860
T Harman	4280
T Cherokee Shale	4480
T Mississippian	4626
T Heebner Sand	4942
T Viola	4952
T Simpson	5138
T Arbuckle	5163

Total Depth 5186
 Elevation 2515' D. F.
 Comp: 3-1-52
 Comp: 4-1-52

Rotary Total Depth 5186
 DRY & ABANDONED

PLUGGING
 FILE SEC-237-223-25W
 BOOK PAGE 6-LINE 7

STATE OF KANSAS:

COUNTY OF SEDGWICK: 58

I, the undersigned, being duly sworn, on oath state that the above statement and log is a true and correct record and log of the well drilled at the location above described.

W. J. COPPINGER

By: A. J. Carter
 A. J. Carter
 Petroleum Engineer

Subscribed and sworn to before me this 4th day of April, 1952.

Henry S. Fisher
 Notary Public

My commission expires April 18, 1955.