

STATE OF KANSAS
STATE CORPORATION COMMISSION


Form CP-4

WELL PLUGGING RECORD

Give All Information Completely
Make Required Affidavit
Mail or Deliver Report to:
Conservation Division
State Corporation Commission
212 No. Market
Wichita, Kansas

KINGMAN County. Sec. 17 Twp. 30s Rge. 9 (X) (W)

Location as "NE/CNW/SW" or footage from lines NE SE
Lease Owner PETROLEUM, INC.,
Lease Name WERNER UNIT Well No. 1
Office Address R.R. #2, GREAT BEND, KANSAS
Character of Well (completed as Oil, Gas or Dry Hole) DRY HOLE
Date well completed MAY 6 19 66
Application for plugging filed MAY 24 19 66
Application for plugging approved MAY 25 19 66
Plugging commenced JUNE 2 19 66
Plugging completed JUNE 15 19 66
Reason for abandonment of well or producing formation NO PRODUCIBLE ZONE

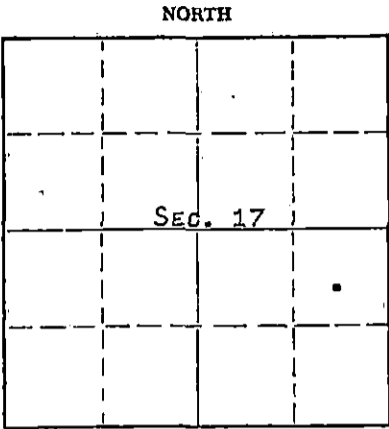

Locate well correctly on above Section Plat

If a producing well is abandoned, date of last production NONE 19
Was permission obtained from the Conservation Division or its agents before plugging was commenced? YES

Name of Conservation Agent who supervised plugging of this well ARCHIE ELVING
Producing formation _____ Depth to top _____ Bottom _____ Total Depth of Well 4319 Feet
Show depth and thickness of all water, oil and gas formations.

OIL, GAS OR WATER RECORDS

CASING RECORD

FORMATION	CONTENT	FROM	TO	SIZE	PUT IN	PULLED OUT
MISSISSIPPI	SMALL AMOUNT	OPEN		5-1/2"	4310'	3260'
	WATER & GAS	HOLE		8-5/8"	209'	NONE

Describe in detail the manner in which the well was plugged, indicating where the mud fluid was placed and the method or methods used in introducing it into the hole. If cement or other plugs were used, state the character of same and depth placed, from _____ feet to _____ feet for each plug set.

PLUGGED BACK TOTAL DEPTH 4252'

FILLED HOLE FROM 4293' TO 4252' W/5 SACKS CEMENT. PUMPED PLUG TO 3700'. MUDDED HOLE TO 200' MADE ROCK BRIDGE FROM 200' TO 190'. DUMPED 25 SACKS CEMENT FROM 190' TO 115'. MUDDED HOLE FROM 115' TO 40'. MADE ROCK BRIDGE FROM 40' TO 30'. DUMPED 10 SACKS CEMENT FROM 30' TO BASE OF WELL CELLAR.

RECEIVED
STATE CORPORATION COMMISSION
JUN 27 1966
6-27-66
CONSERVATION DIVISION
Wichita, Kansas

(If additional description is necessary, use BACK of this sheet)
Name of Plugging Contractor SANTA FE PIPE & SUPPLY INC.
Address R.R. #2, GREAT BEND, KANSAS

STATE OF KANSAS, COUNTY OF BARTON, ss.
MONTE CHADD (employee of owner) or (owner or operator) of the above-described well, being first duly sworn on oath, says: That I have knowledge of the facts, statements, and matters herein contained and the log of the above-described well as filed and that the same are true and correct. So help me God. MONTE CHADD, DIST. PROD. SUPT.

(Signature) *Monte Chadd*

(Address)

SUBSCRIBED AND SWORN TO before me this 24 day of JUNE, 19 66

My commission expires MAY 28, 1969

Richard H. Duncanson
Notary Public.

WELL LOG

COMPANY Petroleum, Inc.

SEC. 17 T. 30S R. 9W

FARM Werner Unit NO. 1


LOC. NE SE

TOTAL DEPTH 4319'

COUNTY Kingman

DDMM. 3-23-66 COMP. 4-2-66

CONTRACTOR Garvey Drilling Company

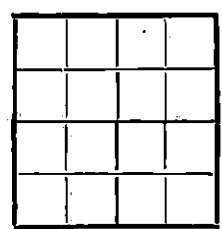

CASING 8 5/8" @ 209' w/200 sx
5 1/2" @ 4310' w/100 sx

ELEVATION 1680' DF

PRODUCTION Mississippi

FIGURES INDICATE BOTTOM OF FORMATIONS

- 40' Surface Sand
- 209' Sand and Shale
- 340' Red Bed and Shale
- 1625' Shale and Shells with Lime and Shale
- 2010' Lime and Shale Streaks
- 2140' Lime with Shale
- 2360' Shale and Lime
- 2605' Shale with Lime Streaks
- 3435' Shale and Lime
- 3440' Lime
- 3685' Shale with Lime
- 4120' Lime
- 4225' Lime and Shale
- 4293' Lime
- 4319' Lime and Shale
- 4319' RTD

RECEIVED
STATE CORPORATION COMMISSION
JUN 27 1966
CONSERVATION DIVISION
Wichita, Kansas

State of Kansas }
County of Barton } ss

I, Sam N. Stephens of Garvey Drilling Company

upon oath state the above and foregoing is a true and correct copy of the log of the Werner No. 1 well.

Sam N. Stephens

Subscribed and sworn to before me this 27th day of April 19 66

My Commission Expires: November 5, 1969

Richard S. Doys
NOTARY PUBLIC

WELL LOG
Werner # 1
C.W/2 NW SE Sec. 17-30S-9W
Kingman County, Kansas

FROM	TO	
0	75	Sand
75	240	Red Bed
240	925	Red Bed & Shale
925	1485	Shale & Shells
1485	2020	Lime & Shale
2020	2388	Shale & Lime
2388	2658	Shale & Sand
2658	3238	Shale & Lime
3238	3425	Lime & Shale
3425	3609	Shale & Lime
3609	3729	Lime & Shale
3729	4305	Lime
4305	4320	Mississippi
4320		Total Depth

Elevation : 1671' K.B.

Formation Tops :

Heebner	3418'
Douglas	3453'
Lansing	3637'
Base K. C.	4119'
Mississippi	4286'
T. D.	4320'

RECEIVED
STATE CORPORATION COMMISSION

SEP 19 1966

CONSERVATION DIVISION
Wichita, Kansas

STATE OF KANSAS

COUNTY OF BARTON ss.

T. D. Sweetman, Partner of S & S Drilling Company, being first duly sworn on oath says: That I have knowledge of the facts, statements and matters herein contained and the log of the above described well as filed and that the same are true and correct.

T. D. Sweetman
T. D. Sweetman

Suscribed and sworn before me this 6th day of September, 1966.

Blata L. Boyd
Notary Public Barton County

My Commission Expires 5/9/67