

STATE OF KANSAS
STATE CORPORATION COMMISSION

WELL PLUGGING RECORD

Give All Information Completely
Make Required Affidavit
Mail or Deliver Report to
Conservation Division
State Corporation Comm.
245 North Water
Wichita, KS 67202


Kingman County. Sec. 14 Twp. 30S Rge. 9W E/W
Location as "NE/CNW $\frac{1}{4}$ SW $\frac{1}{4}$ " or footage from lines
C NE NE

Lease Owner John C. Graves (Graves Drilling Co., Inc.)
Lease Name Swingle Well No. 1-14

Office Address 910 Union Center

Character of Well (Completed as Oil, Gas or Dry Hole)
Dry Hole

Date Well completed Jan. 10 19 78
Application for plugging filed Jan. 10 19 78
Application for plugging approved Jan. 10 19 78
Plugging commenced Jan. 10 19 78
Plugging completed Jan. 10 19 78
Reason for abandonment of well or producing formation

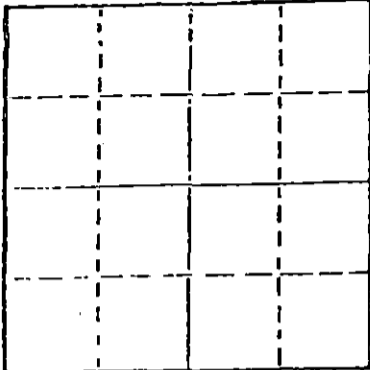

Locate well correctly on above
Section Plat

If a producing well is abandoned, date of last production
19

Was permission obtained from the Conservation Division or
its agents before plugging was commenced? Yes

Name of Conservation Agent who supervised plugging of this well William T. Owen
Producing formation Depth to top Bottom Total Depth of Well 4325
Show depth and thickness of all water, oil and gas formations.

OIL, GAS OR WATER RECORDS

CASING RECORD

FORMATION	CONTENT	FROM	TO	SIZE	PUT IN	PULLED OUT
				8 5/8	220'	NONE

Describe in detail the manner in which the well was plugged, indicating where the mud fluid was placed and the method or methods used in introducing it into the hold. If cement or other plugs were used, state the character of same and depth placed, from feet to feet for each plug set.

Mudded up with heavy mud to 240 feet. Followed by wooden plug and $\frac{1}{2}$ sack hulls. Placed 35 sacks cement onto hulls. Mudded up with heavy mud to 40 feet followed by wooden plug, $\frac{1}{2}$ sack hulls and 15 sacks cement to base of well cellar. Plugged rat hole with 5 sacks cement.

RECEIVED
STATE CORPORATION COMMISSION
1-27-78

JAN 27 1978

(If additional description is necessary, use BACK of this sheet)

Name of Plugging Contractor Graves Drilling Co., Inc
Wichita, Kansas 910 Union Center, Wichita, Kansas 67202

STATE OF Kansas COUNTY OF Sedgwick, ss.
John C. Graves (Employee of owner) or (owner or operator)
of the above-described well, being first duly sworn on oath, says: That I have knowledge of the facts, statements, and matters herein contained and the log of the above-described well as filed and that the same are true and correct. So help me God.

(Signature) John C. Graves
910 Union Center, Wichita, Kansas
(Address)

SUBSCRIBED AND SWORN TO before me this 25th day of January, 1978

Betty Brandt
Notary Public.

My commission expires May 9, 1979

R O T A R Y D R I L L E R S ' L O G

CONTRACTOR: Graves Drilling Co., Inc. DRILLING COMMENCED: January 3, 1978
 910 Union Center
 Wichita, Kansas 67202

OPERATOR: Graves Drilling Co., Inc. DRILLING COMPLETED: January 10, 1978
 910 Union Center
 Wichita, Kansas 67202

CASING RECORD: 5 Jts. 220' 8-5/8 used LOCATION: Swingle No. 1-14
 cemented with 215' sacks C NE NE
 Section 14-30S-9W
 Kingman County, Kansas

0 - 75 Sand & Red Bed
 75 - 454 Red Bed
 454 - 1343 Red Bed & Shale
 1343 - 1473 Shale & Lime
 1473 - 2592 Lime & Shale
 2596 - 2826 Shale
 2826 - 3886 Shale & Lime
 3886 - 4287 Lime
 4287 - 4305 Lime & Chert
 4305 - 4325 Lime
 4325 Total Depth

I hereby certify the foregoing statements to be true and correct to the best of my knowledge.

RECEIVED
 STATE CORPORATION COMMISSION
 JAN 27 1978
 CONSERVATION DIVISION
 Wichita, Kansas

GRAVES DRILLING CO., INC.

By John Graves
 President

STATE OF KANSAS)
) ss.
 SEDGWICK COUNTY)

Subscribed and sworn to before me a Notary Public, this 25th day of January, 1978.

Betty Brandt
 Betty Brandt Notary Public

My commission expires: May 9, 1979