


15.075.10006.00.00

WELL PLUGGING RECORD

Give All Information Completely  
Make Required Affidavit  
Mail or Deliver Report to:  
Conservation Division  
State Corporation Commission  
211 No. Broadway  
Wichita, Kansas

NORTH

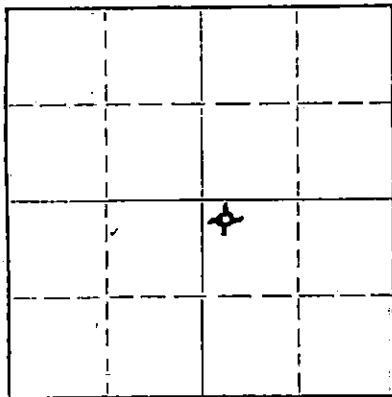

Locate well correctly on above  
Section Plat

Hamilton County. Sec. 5 Twp. 21S Rge. (E) 41(W)  
Location as "NE/CNW/SW" or footage from lines NW - NW - SE  
Lease Owner Champlin Oil & Refining Co.  
Lease Name Kuykendall Well No. 1  
Office Address Box 308, Ellinwood, Kansas  
Character of Well (completed as Oil, Gas or Dry Hole) Dry Hole  
Date well completed September 8 1962  
Application for plugging filed September 21 1962  
Application for plugging approved September 24 1962  
Plugging commenced September 24 1962  
Plugging completed September 26 1962  
Reason for abandonment of well or producing formation \_\_\_\_\_

If a producing well is abandoned, date of last production \_\_\_\_\_ 19\_\_\_\_  
Was permission obtained from the Conservation Division or its agents before plugging was commenced? Yes

Name of Conservation Agent who supervised plugging of this well Hugh Scott  
Producing formation \_\_\_\_\_ Depth to top \_\_\_\_\_ Bottom \_\_\_\_\_ Total Depth of Well 2875 Feet  
Show depth and thickness of all water, oil and gas formations.

OIL, GAS OR WATER RECORDS

CASING RECORD

FORMATION	CONTENT	FROM	TO	SIZE	PUT IN	PULLED OUT
				7 5/8" OD	211'	None
				4 1/2" OD	2874'	1136'

Describe in detail the manner in which the well was plugged, indicating where the mud fluid was placed and the method or methods used in introducing it into the hole. If cement or other plugs were used, state the character of same and depth placed, from \_\_\_\_\_ feet to \_\_\_\_\_ feet for each plug set.

Bridging plug at 2810' with one sack of cement on top making PBD 2805'. Filled hole with cement from 2805 to 2765' using 4 sacks of cement then filled hole with mud to 200' and set 10' rock bridge and dumped in 35 sacks of cement filling hole to 45' and set 10' rock bridge and filled hole to bottom of cellar using 15 sacks of cement.

RECEIVED  
STATE CORPORATION COMMISSION

OCT 2 1962 10-2-62

CONSERVATION DIVISION  
Wichita, Kansas

(If additional description is necessary, use BACK of this sheet)

Name of Plugging Contractor Central Pipe Pulling Co.  
Address 1416 Coolidge, Great Bend, Kansas

STATE OF Kansas, COUNTY OF Barton, ss.  
J. W. Meyers (employee of owner) or ~~owner~~ of the above-described well, being first duly sworn on oath, says: That I have knowledge of the facts, statements, and matters herein contained and the log of the above-described well as filed and that the same are true and correct. So help me God.

(Signature) J. W. Meyers  
Box 308, Ellinwood, Kansas  
(Address)

SUBSCRIBED AND SWORN to before me this 1st day of October 1962

My commission expires 5-22-66

Notary Public.



15.075.10006.00.00

RECEIVED  
STATE CORPORATION COMMISSION

SEP 24 1950

CONSERVATION DIVISION  
Wichita

Champlin Oil & Refining Co.  
W. D. Kuykendall #1  
NW-NW-SE Sec. 5-21S-41W  
Hamilton County, Kansas

Formation Log

0' - 40'	Surface soil & sand
40' - 120'	Clay & sand
120' - 213'	Shale
213' - 300'	Shale & sand
300' - 1810'	Shale & shells
1810' - 2220'	Shale & salt
2220' - 2465'	Lime & anhydrite
2465' - 2875'	Lime & shale
2875' -	Total Depth