


STATE OF KANSAS
STATE CORPORATION COMMISSION

WELL PLUGGING RECORD

Give All Information Completely
Make Required Affidavit
Mail or Deliver Report to
Conservation Division
State Corporation Comm.
245 North Water
Wichita, KS 67202

Hamilton County, Sec. 4, Twp. 22 Rge. 39
Location as "NE/CNW $\frac{1}{4}$ /SW $\frac{1}{4}$ " or footage from lines
80' SE of C of NW $\frac{1}{4}$

Lease Owner Osborn Heirs
Lease Name Meisel Well No. 1
Office Address Box 17968, San Antonio, TX 78286
Character of Well (Completed as Oil, Gas or Dry Hole)
Gas

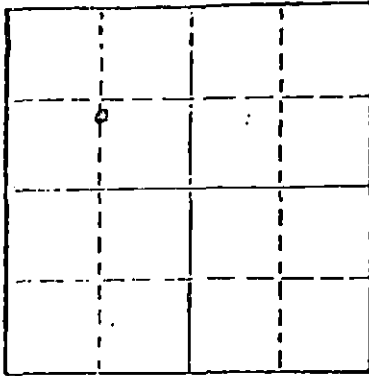

Locate well correctly on above
Section Plot

Date Well completed 19
Application for plugging filed 12-28-81 19
Application for plugging approved 1-5-82 19
Plugging commenced 1-6-82 19
Plugging completed 1-8-82 19

Reason for abandonment of well or producing formation
Non Commercial Value
If a producing well is abandoned, date of last production
None 19

Was permission obtained from the Conservation Division or
its agents before plugging was commenced? yes

Name of Conservation Agent who supervised plugging of this well Mr. Thomas
Producing formation Huggton Depth to top 271 Bottom 2720 Total Depth of Well 3182
Show depth and thickness of all water, oil and gas formations.

OIL, GAS OR WATER RECORDS

CASING RECORD

FORMATION	CONTENT	FROM	TO	SIZE	PUT IN	PULLED OUT
Surface				8 5/8"	322'	0'
Production				5 1/2"	3182'	2024'

Describe in detail the manner in which the well was plugged, indicating where the mud fluid
was placed and the method or methods used in introducing it into the hold. If cement or other
plugs were used, state the character of same and depth placed, from feet to
feet for each plug set.

Pumped 2 sks. hulls & 25 sks. cement to 2550' - Pressured to 750 lbs.
Displaced w/mud to 300"
Pumped 40 sks. cement 300' to 200'
Displaced w/mud to 40"
Put bridge & 10 sks. cement 40" to 0
Cut off 8 5/8", 3" below ground level

(If additional description is necessary, use BACK of this sheet)

Name of Plugging Contractor Midwest Casing Pulling Service
Permit # 766

STATE OF KANSAS COUNTY OF HASKELL, ss.
I, Edgar J. Eves (Employer/Owner/Operator)

of the above-described well, being first duly sworn on oath, says: That I have knowledge of
the facts, statements, and matters herein contained and the log of the above-described well
as filed and that the same are true and correct. So help me God.

(Signature) Edgar J. Eves
Box F, Sublette, Ks. 67877
(Address)

SUBSCRIBED AND SWORN TO before me this 20th day of Jan., 19 82

Sondra L Eves
Notary Public.

My commission expires 12 - 6 - 84

RECEIVED
STATE CORPORATION COMMISSION



FEB 25 1982
CONSERVATION DIVISION
Wichita, Kansas

2-25-82

RECEIVED
COMMUNICATIONS SECTION

RECEIVED

RECEIVED
FEB 18 1982
COMMUNICATIONS SECTION