


15.075.30021.00.00

WELL PLUGGING RECORD

Give All Information Completely
Make Required Affidavit
Mail or Deliver Report to:
Conservation Division
State Corporation Commission
211 No. Broadway
Wichita, Kansas

Hamilton County, Sec. 4 Twp. 23S Rge. 40W (E) (W)
Location as "NE/CNW/SW" or footage from lines C-SE-NW
Lease Owner Sunray DX Oil Company
Lease Name C.E. Eagle Well No. 1
Office Address 300 Union National Bldg. Wichita, Kansas
Character of Well (completed as Oil, Gas or Dry Hole) Dry hole
Date well completed 3-15 1965
Application for plugging filed 4-9 1965
Application for plugging approved 4-13 1965
Plugging commenced 5-12 1965
Plugging completed 5-12 1965
Reason for abandonment of well or producing formation Dry hole

NORTH

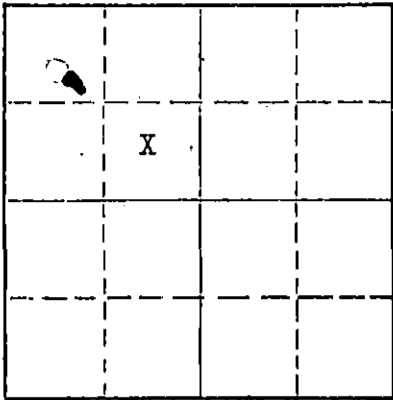

Locate well correctly on above Section Plat

If a producing well is abandoned, date of last production 19
Was permission obtained from the Conservation Division or its agents before plugging was commenced? Yes

Name of Conservation Agent who supervised plugging of this well Hugh Scott Box "F" Sublette, Kansas
Producing formation Depth to top Bottom Total Depth of Well 2640 Feet
Show depth and thickness of all water, oil and gas formations.

OIL, GAS OR WATER RECORDS

CASING RECORD

FORMATION	CONTENT	FROM	TO	SIZE	PUR IN	PULLED OUT
				8 5/8	382	0
				1 1/2	2639	388

Describe in detail the manner in which the well was plugged, indicating where the mud fluid was placed and the method or methods used in introducing it into the hole. If cement or other plugs were used, state the character of same and depth placed, from feet to feet for each plug set.

Mud from 2400' to 387'. Rock bridge from 387' to 380'. 35 sacks of cement from 380' to 280'. Mud from 280' to 45'. Wooden plug at 45'. Filled to surface with 15 sacks of cement.

RECEIVED
STATE CORPORATION COMMISSION
MAY 14 1965
CONSERVATION DIVISION
Wichita, Kansas

(If additional description is necessary, use BACK of this sheet)
Name of Plugging Contractor Wakefield Drilling Company
Address 515 Union Center Building Wichita, Kansas

5-14-65

STATE OF Kansas, COUNTY OF Sedgwick, ss.
V.A. Tracy (employee of owner) or (owner/operator) of the above-described well, being first duly sworn on oath, says: That I have knowledge of the facts, statements, and matters herein contained and the log of the above-described well as filed and that the same are true and correct. So help me God.

(Signature) V.A. Tracy
300 Union National Bldg. Wichita, Kansas
(Address)

SUBSCRIBED AND SWORN to before me this 13th day of May, 1965

Agnes M. Quinn
Notary Public.

My commission expires March 24, 1967.

LEASE: C. E. EAGLE #1
OWNER: SUNRAY OIL COMPANY
CONT: EARL F. WAKEFIELD
COMP: 2-9-65
COMP: 2-14-65

LOCATION: C SE NW
SECTION 4-23S-40W
HAMILTON COUNTY, KANSAS
CASING: 6 5/8" Set @ 383'
4 1/2" Set @ 2640'

Shale 260
Sand & Anhydrite 383
Shale 1760
Lime - Shale 2008
Anhydrite 2148
Anhydrite, Sand, Shale 2299
Lime & Shale 2640
R.T.D.

RECEIVED
STATE CONSERVATION COMMISSION
MAY 14 1965
CONSERVATION DIVISION
Wichita, Kansas

STATE OF KANSAS)
) SS
COUNTY OF SEDGWICK)

I, FRED S. BARKER, DO HEREBY CERTIFY THAT THE ABOVE IS A TRUE AND
CORRECT COPY OF THE DRILLER'S LOG ON THE C. E. EAGLE #1, LOCATED
IN THE C SE NW OF SECTION 4-23S-40W, HAMILTON COUNTY, KANSAS.

EARL F. WAKEFIELD

BY Fred S. Barker
Fred S. Barker

SUBSCRIBED AND SWORN TO BEFORE ME THIS 19TH DAY OF FEBRUARY, 1965.

MY COMMISSION EXPIRES:
JANUARY 25, 1969

Wanda D. Riley
NOTARY PUBLIC