


WELL PLUGGING RECORD

Give All Information Completely
Make Required Affidavit
Mail or Deliver Report to:
Conservation Division
State Corporation Commission
212 North Market, Insurance Bldg.
Wichita, Kansas

Russell County, Sec. 6 Twp. 13S Rge. 14 (E) W (W)
Location as "NE/CNW%SW%" or footage from lines W/2 NW/4 SE/4

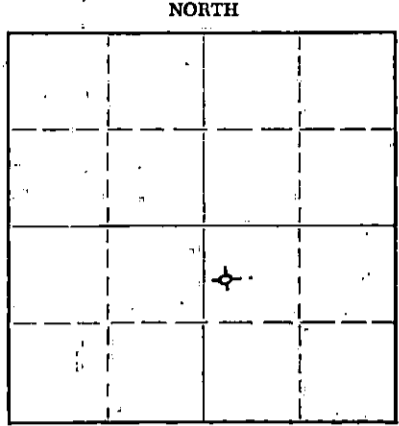

Locate well correctly on above Section Plat

Lease Owner M. P. Springer
Lease Name Woelk "A" Well No. 1
Office Address 308 Springer Bldg., 6th & Cincinnati, Tulsa 19, Okla.
Character of Well (completed as Oil, Gas or Dry Hole) Dry Hole
Date well completed November 9, 1960
Application for plugging filed (Verbal) November 9, 1960
Application for plugging approved (Verbal) November 9, 1960
Plugging commenced November 10, 1960
Plugging completed November 10, 1960
Reason for abandonment of well or producing formation Dry Hole

If a producing well is abandoned, date of last production 19
Was permission obtained from the Conservation Division or its agents before plugging was commenced? Yes

Name of Conservation Agent who supervised plugging of this well Don Truan
Producing formation _____ Depth to top _____ Bottom _____ Total Depth of Well 3075 Feet
Show depth and thickness of all water, oil and gas formations.

OIL, GAS OR WATER RECORDS

CASING RECORD

FORMATION	CONTENT	FROM	TO	SIZE	PUT IN	PULLED OUT
		0	271'	8-5/8"	271'	none

Describe in detail the manner in which the well was plugged, indicating where the mud fluid was placed and the method or methods used in introducing it into the hole. If cement or other plugs were used, state the character of same and depth placed, from _____ feet to _____ feet for each plug set.

First plug set at 260' with 1/2 sack hulls and 25 sacks cement. Second plug set at 40' with 1/2 sack hulls and 10 sacks cement.

RECEIVED
STATE CORPORATION COMMISSION

NOV 16 1960

CONSERVATION DIVISION
Wichita, Kansas 11-16-60

(If additional description is necessary, use BACK of this sheet)
Name of Plugging Contractor Birmingham-Bartlett Drilling Co.
Address 300 Kaufman Bldg., Wichita 2, Kansas

STATE OF KANSAS COUNTY OF SEDGWICK
Richard Hindery, partner of Birmingham-Bartlett Drilling Co., contractor (employee of owner) or (owner or operator) of the above-described well, being first duly sworn on oath, says: That I have knowledge of the facts, statements, and matters herein contained and the log of the above-described well as filed and that the same are true and correct. So help me God. BIRMINGHAM-BARTLETT DRILLING CO.

(Signature) BY Richard Hindery Partner
300 Kaufman Bldg., Wichita 2, Kansas (Address)

SUBSCRIBED AND SWORN TO before me this 14th day of November, 19 60.

My commission expires October 2, 1962. Beverly Larson Notary Public.

