


15.167.01675.00.00

WELL PLUGGING RECORD

Give All Information Completely
Make Required Affidavit
Mail or Deliver Report to:
Conservation Division
State Corporation Commission
800 Bittling Building
Wichita, Kansas

NORTH

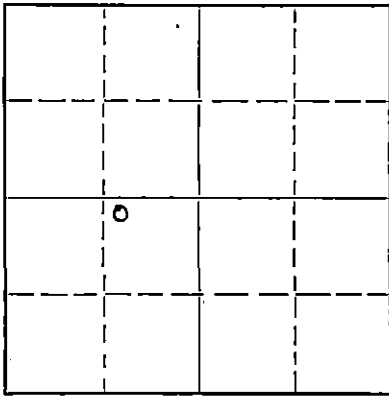

Locate well correctly on above
Section Plat

Russell County, Sec 22 Twp 13 Rge 14 (E) W (W)
Location as "NE/CNW $\frac{1}{4}$ SW $\frac{1}{4}$ " or footage from lines NW/4 NE/4 SW/4
Lease Owner V.D. Sidey Oil Company
Lease Name V.D. Sidey Oil Co-Steinle Well No. 1
Office Address Russell, Kansas.
Character of Well (completed as Oil, Gas or Dry Hole)
Date well completed February 22, 1952 19
Application for plugging filed August 22, 1952 19
Application for plugging approved August 25, 1952 19
Plugging commenced August 21 19 52
Plugging completed August 22 19 52
Reason for abandonment of well or producing formation

If a producing well is abandoned, date of last production 19
Was permission obtained from the Conservation Division or its agents before plugging was commenced?

Name of Conservation Agent who supervised plugging of this well ~~Blair~~ Charley Stough
Producing formation Depth to top Bottom Total Depth of Well 3268 Feet
Show depth and thickness of all water, oil and gas formations.

OIL, GAS OR WATER RECORDS

CASING RECORD

Formation	Content	From	To	Size	Put In	Pulled Out

Describe in detail the manner in which the well was plugged, indicating where the mud fluid was placed and the method or methods used in introducing it into the hole. If cement or other plugs were used, state the character of same and depth placed, from 3268 feet to SURFACE feet for each plug set.

Hole filled with sand from 3268 to 3260; Fivesacks of cement placed with dump bailer to form cement plug from 3260 to 3220; Hole filled with mud from 3220 to 200 feet; Rock bridge installed between 200 feet to 196 feet; thirty sacks of cement poured in hole forming cement plug from 196 feet to 85 feet; hole filled with mud from 85 feet to 20 feet; rock bridge installed from 20 to fifteen feet; hole capped with five sacks of cement.

(If additional description is necessary, use BACK of this sheet)

Name of Plugging Contractor Barnes and Sons Pipe Pulling Co
Address Russell, Kansas.

STATE OF KANSAS, COUNTY OF RUSSELL, ss.

(employee of owner) or (owner or operator) of the above-described well, being first duly sworn on oath, says: That I have knowledge of the facts, statements, and matters herein contained and the log of the above-described well as filed and that the same are true and correct. So help me God.

(Signature) *V.D. Sidey*
Box 387 Russell, Kansas
(Address)

SUBSCRIBED AND SWORN TO before me this 3rd day of September, 1952.

My commission expires

April 4, 1956
PLUGGING
23-8390-5
FILE SEC 22 T 13 R 14
BOOK PAGE 39 LINE 38

6-51-20M

Lorita St. Embury Notary Public.

STATE CORPORATION COMMISSION

SEP 5 - 1952

CONSERVATION DIVISION
Wichita, Kansas

9-5-52

SIDEY DRILLING COMPANY

BUILDING & LOAN BLDG. P. O. BOX 387

RUSSELL, KANSAS

COMPANY V. D. Sidey Oil Company

SEC. 22 T. 13 R. 14 W.
Loc. NW NE SW

FARM Steinle NO. 1

TOTAL DEPTH 3267 1/2'
COMM. 2-10-52 COMP. 2-22-52
SHOT OR TREATED
CONTRACTOR Sidey Drilling Company
ISSUED

COUNTY Russell

CASING
20" 10'
15 3/4" 8 1/4" 110'
12 1/2" 6 3/4"
13 1/2" 5 5/16" 3266 1/2'

ELEVATION 1843 R.

PRODUCTION

FIGURES INDICATE BOTTOM OF FORMATIONS

65	Shale and Shells	885	Anhydrite
70	Sand	1105	Shale & shells
109	Shale	1295	Salt and shale
110	Shells	1575	Shale & shells
120	Shale & shells	1675	Broken lime
160	Shale	1715	Shale & lime
240	Shale & Shells	1825	Broken lime
270	Shale & Red Rock	1905	Lime
310	Shale	2065	Shale & lime
365	Sand	2656	Shale
375	Hard sand	2730	Lime & shale
385	Sand & shale	2875	Lime
395	Hard sand	3045	Lime & shale
450	Shale	3090	Lime
480	Sand	3125	Lime & shale
515	Shale	3190	Lime
525	Sand	3267	Lime TD
635	Red bed		

STATE OF KANSAS, COUNTY OF RUSSELL ss.

I, V. D. Sidey, of the Sidey Drilling Company, upon oath state that the above and foregoing is a true and correct copy of the log of the Steinle # 1 well.

V. D. Sidey
V. D. Sidey

Subscribed and sworn to before me this 4 day of August, 1952.

My Commission Expires: April 19, 1951

Notary Public
Notary Public

PLUGGING
 FILE SEC 22 T. 13 R. 14 W.
 BOOK PAGE 39 LINE 32

RECEIVED
 STATE CORPORATION COMMISSION
 SEP 5 - 1952
 CONSERVATION DIVISION
 Wichita, Kansas