


Give All Information Completely  
Make Required Affidavit  
Mail or Deliver Report to:  
Conservation Division  
State Corporation Commission  
800 Bitting Building  
Wichita, Kansas

WELL PLUGGING RECORD

NORTH

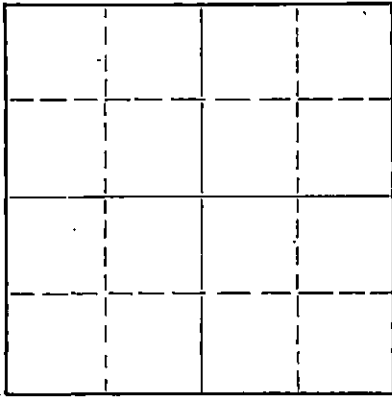

Locate well correctly on above Section Plat

Russell County, Sec. 9 Twp. 14 Rge. 12 (E) W (W)  
Location as "NE/CNW/SW" or footage from lines SW NE SW  
Lease Owner Kessler and Schmidt  
Lease Name Mahoney Well No. 1  
Office Address Russell, Kansas  
Character of Well (completed as Oil, Gas or Dry Hole) Dry Hole  
Date well completed July 12 19 54  
Application for plugging filed July 12 19 54  
Application for plugging approved July 12 19 54  
Plugging commenced July 12 19 54  
Plugging completed July 12 19 54  
Reason for abandonment of well or producing formation Dry

If a producing well is abandoned, date of last production 19  
Was permission obtained from the Conservation Division or its agents before plugging was commenced? Yes

Name of Conservation Agent who supervised plugging of this well \_\_\_\_\_  
Producing formation \_\_\_\_\_ Depth to top \_\_\_\_\_ Bottom \_\_\_\_\_ Total Depth of Well 3352 Feet  
Show depth and thickness of all water, oil and gas formations.

OIL, GAS OR WATER RECORDS

CASING RECORD

FORMATION	CONTENT	FROM	TO	SIZE	PUT IN	PULLED OUT
				8 5/8"	241'	None

Describe in detail the manner in which the well was plugged, indicating where the mud fluid was placed and the method or methods used in introducing it into the hole. If cement or other plugs were used, state the character of same and depth placed, from \_\_\_\_\_ feet to \_\_\_\_\_ feet for each plug set.

Filled hole with heavy mud to 235 ft., set bottom plug, used 1/2 sack hulls and 15 sacks cement. Filled hole with heavy mud to 35', set top plug, used 1/2 sack hulls and 10 sacks cement. Filled hole to bottom of cellar.

RECEIVED  
STATE CORPORATION COMMISSION  
CONSERVATION DIVISION  
7-30-54

(If additional description is necessary, use BACK of this sheet)  
Name of Plugging Contractor Duke & Wood Drilling Company  
Address Box 123, Great Bend, Kansas

STATE OF Kansas, COUNTY OF Barton, ss.  
Lynn O. Duke (employee of owner) or (owner or operator) of the above-described well, being first duly sworn on oath, says: That I have knowledge of the facts, statements, and matters herein contained and the log of the above-described well as filed and that the same are true and correct. So help me God.

(Signature) Lynn O. Duke  
Great Bend, Kansas  
(Address)

SUBSCRIBED AND SWORN to before me this 23rd day of July, 19 54  
Dean L. Cooley  
Notary Public.

My commission expires April 29, 1957

PLUGGING  
FILED SEC 9 T 14 R 12W  
BOOK PAGE 48 LINE 34

WELL LOG  
 Mahoney #1  
 SW NE SW of 9-14-12W  
 Russell County, Kansas

Started: June 30, 1954  
 Completed: July 12, 1954

Elevation 1832 KB  
 Anhydrite 738 (-1094)  
 Tarkio 2323 (-491)  
 Heebner 2891 (-1059)  
 Lansing 2971 (-1139)  
 Arbuckle 3332 (-1500)

0-78	Surface clay, post rock, shale
78-160	Sand, shale rock
160-241	Blue shale and clay
241-410	Shale, clay and hard sand
410-738	Shale, clay and red bed
738-774	Anhydrite
774-1205	Shale and shells
1205-1335	Salt and shale
1335-1640	Shale and shells
1640-1935	Shale, shells, lime streaks
1935-2300	Lime and shale
2300-2520	Sand, lime and shale
2520-2623	Lime and shale
2623-2880	Lime
2880-3140	Lime
3140-3352	Lime
3352	ROTARY TOTAL DEPTH

A F F I D A V I T

STATE OF Kansas, COUNTY OF Barton, SS

I, Lynn O. Duke, of the DUKE & WOOD DRILLING COMPANY being first duly sworn on oath, state; That I have knowledge of the facts, statements and matters herein contained and that the same are true and correct.

*Lynn O. Duke*  
 Partner

Subscribed and sworn to before me this 23<sup>rd</sup> day of July, 1954.

*Dean T. Lookey*  
 Notary Public  
 STATE OF KANSAS COMMISSION

My commission expires: April 29, 1957.

**PLUGGING**  
 FILE SEC 9 T 14 R 12W  
 BOOK PAGE 48 LINE 34

JUL 30 1954  
 CONSERVATION DIVISION  
 Wichita, Kansas