

15-155-30219-0000


STATE OF KANSAS
STATE CORPORATION COMMISSION

Give All Information Completely
Make Required Affidavit
Mail or Deliver Report to:
Conservation Division
State Corporation Commission
800 Blitting Building
Wichita, Kansas

WELL PLUGGING RECORD
OR
FORMATION PLUGGING RECORD

Strike out upper line
when reporting plug-
ging off formations.

NORTH

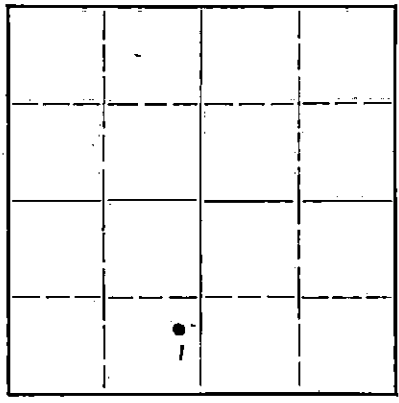

Locate well correctly on above
Section Plat

Reno County, Sec. 14 Twp. 23 Rge. (E) 10 (W)
Location as "NE 1/4 NW 1/4 SW 1/4" or footage from lines 990' N. and 330' W. of S/4 Cor.
Lease Owner Cities Service Oil Company
Lease Name Lang "A" Well No. 2
Office Address Bartlesville, Oklahoma
Character of Well (completed as Oil, Gas or Dry Hole) Dry Hole
Date well completed March 23, 1943
Application for plugging filed March 23, 1943
Application for plugging approved March 23, 1943
Plugging commenced March 24, 1943
Plugging completed March 24, 1943
Reason for abandonment of well or producing formation No productive strata found.

If a producing well is abandoned, date of last production 19
Was permission obtained from the Conservation Division or its agents before plugging was com-
menced? Yes

Name of Conservation Agent who supervised plugging of this well Ruel Durkee, McPherson, Kansas
Producing formation Viola Depth to top 3795 Bottom 3812 Total Depth of Well 3812 Feet
Show depth and thickness of all water, oil and gas formations.

OIL, GAS OR WATER RECORDS

CASING RECORD

| Formation | Content | From | To | Size | Put In | Pulled Out |
|-----------|---------|------|------|---------|--------|------------|
| Viola | Barren | 3795 | 3812 | 10-3/4" | 175' | None |
| | | | | | | |
| | | | | | | |
Describe in detail the manner in which the well was plugged, indicating where the mud fluid was placed and the method or methods used in introducing it into the hold. If cement or other plugs were used, state the character of same and depth placed, from feet to feet for each plug set.

10-3/4" surface casing cemented at 175' with 150 sacks. Hole was plugged with heavy rotary mud from 3812 to 165'. A wooden plug was driven to 150' and 15 sacks cement spotted 150' to 135'. Soil used to fill 135' to 25' and 5 sacks cement from 25' to cellar base.

4-19-43

14 23 10W
BOOK PAGE 68 NE-16

(If additional description is necessary, use BACK of this sheet)

Correspondence regarding this well should be addressed to R. C. Hauber
Address Cities Service Oil Co., Great Bend, Kansas

STATE OF Kansas, COUNTY OF Barton, ss.
J. A. Deffeyes (employee of owner) or (owner or operator) of the above-described well,

being first duly sworn on oath, says: That I have knowledge of the facts, statements, and matters herein contained and the log of the above-described well as filed and that the same are true and correct. So help me God.

(Signature) [Signature]
Box 751, Great Bend, Kansas
(Address)

SUBSCRIBED AND SWORN TO before me this 30 day of March, 1943

[Signature]
Notary Public.

My commission expires My Commission Expires Sept. 26, 194

WELL RECORD

15-155-30219-0000

Company Cities Service Oil Co. Well No. 2 Farm Lang "A"
 Location 990' North and 330' West of S/4 CORNER Sec. 14 T. 23 R. 10W
 Elevation 1763 County Reno State Kansas
 Drlg. Comm. March 4, 1943 Contractor Corbett-Barbour Drilling Company
 Drlg. Comp. March 22, 1943 Acid None
 T. D. 3812' Initial Prod. Dry - P. & A.

CASING RECORD:

10-3/4" @ 175' cen. 150 sx Monarch
 and 200# C. C.

FORMATION RECORD:

| | |
|-------------------------|------------|
| sand & shale | 0-160 |
| red bed | 175 |
| shale, shells & red bed | 400 |
| shale & shells | 1325 |
| shale & lime | 1405 |
| anhydrite & shale | 1455 |
| shale & lime shells | 1560 |
| shale & lime | 1660 |
| broken lime | 1735 |
| sand | 1760 |
| shale & shells | 1865 |
| lime, cherty | 1910 |
| broken lime | 2130 |
| lime & shale | 2300 |
| shale & shells | 2337 |
| shale & lime | 2380 |
| shale | 2450 |
| shale & lime | 2515 |
| lime | 2570 |
| shale & shells | 2610 |
| lime & shale | 2670 |
| shale & lime | 2765 |
| lime | 3107 |
| sandy lime & shale | 3210 |
| shale | 3237 |
| lime | 3405 |
| chert | 3414 |
| lime | 3493 |
| lime & shale | 3511 |
| lime | 3594 |
| lime & shale | 3630 |
| chert | 3660 |
| lime | 3674 |
| shale & lime shells | 3712 |
| shale | 3795 |
| lime & chert | 3812 T. D. |

Top Viola 3795'
 Penetration 17'
 Total Depth 3812'

Syfo: 500' 0°
 1500' 0°
 2000' 0°
 2500' 0°
 3000' 0°
 3500' 0°

PLUGGING
 FILE 15-155-30219-10W
 BOOK PAGE 68 LINE 16

