


15-155-02362-0006

STATE OF KANSAS
STATE CORPORATION COMMISSION
Give All Information Completely
Make Required Affidavit
Mail or Deliver Report to:
Conservation Division
State Corporation Commission
800 Blifling Building
Wichita, Kansas

WELL PLUGGING RECORD
OR
FORMATION PLUGGING RECORD

Strike out upper line
when reporting plug-
ging of formations.

NORTH

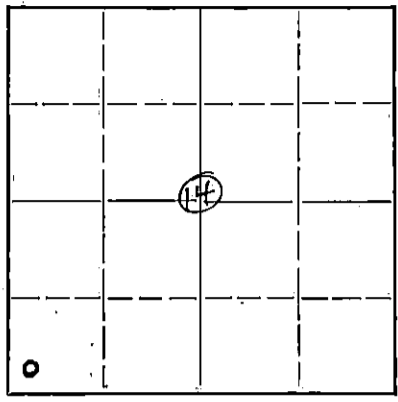

Locate well correctly on above
Section Plat

Reno County, Sec. 14 Twp. 23S. Rge. 10 (W)
Location as "NE 1/4 NW 1/4 SW 1/4" or footage from lines C SW/4 SW/4
Lease Owner **Cities Service Oil Company**
Lease Name **Lang** Well No. **1**
Office Address **Bartlesville, Okla.**
Character of Well (completed as Oil, Gas or Dry Hole)
Date well completed **October 18,** 19 **42**
Application for plugging filed **October 18,** 19 **42**
Application for plugging approved **October 18,** 19 **42**
Plugging commenced **October 18,** 19 **42**
Plugging completed **October 18,** 19 **42**
Reason for abandonment of well or producing formation **Lost the hole**

If a producing well is abandoned, date of last production 19
Was permission obtained from the Conservation Division or its agents before plugging was commenced? **Yes**
Name of Conservation Agent who supervised plugging of this well **C. T. Alexander**
Producing formation Depth to top Bottom Total Depth of Well **1910** Feet
Show depth and thickness of all water, oil and gas formations.

OIL, GAS OR WATER RECORDS CASING RECORD

Formation	Content	From	To	Size	Put In	Pulled Out
				8"	148'	None

Describe in detail the manner in which the well was plugged, indicating where the mud fluid was placed and the method or methods used in introducing it into the hold. If cement or other plugs were used, state the character of same and depth placed, from feet to feet for each plug set.
Cement plug at 125' - 15 sacks cement
Plug on top from ground 25' - 10 sacks cement

Formation Record

Formation	Top	Bottom
Sand & Clay	0	132
Red Bed	132	149
Red Bed & Shale	149	506
Shale	506	878
Shale & Sand	878	1215
Sandy Lime	1215	1570
Lime	1570	1582
Shale & Sand	1582	1695
Sand & Lime	1695	1865
Shale & Lime	1865	1905
Sand & Lime	1905	1910 T.D.

10-30-42

(If additional description is necessary, use BACK of this sheet)
Correspondence regarding this well should be addressed to **Mercury Drilling Company**
Address **609 National Bank of Tulsa Bldg., Tulsa, Okla.**

STATE OF **OKLAHOMA**, COUNTY OF **TULSA**, ss.
CHESTER H. WESTFALL (employee of owner) or (owner or operator) of the above-described well,
being first duly sworn on oath, says: That I have knowledge of the facts, statements, and matters herein contained and the log of the above-described well as filed and that the same are true and correct. So help me God.

(Signature) **Mercury Drilling Company**
C. Hester Westfall
National Bank Tulsa Bldg., Tulsa, Okla.
(Address)

SUBSCRIBED AND SWORN to before me this **27th** day of **October**, 19 **42**
Rene Hare
Notary Public.

My commission expires **April 19, 1945**
PLUGGING
FILE SEC-14-T-23 R 14 W
BOOK PAGE-53-LINE 44