


Give All Information Completely
Make Required Affidavit
Mail or Deliver Report to:
Conservation Division
State Corporation Commission
800 Biting Building
Wichita, Kansas

WELL PLUGGING RECORD

T 23s NORTH R 10w

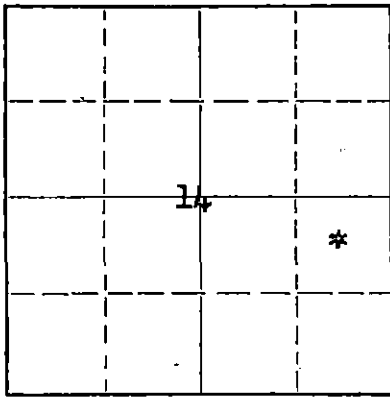

Locate well correctly on above Section Plat

Reno County, Sec. 14 Twp. 23S Rge. 10W (E) (W)
Location as "NE/CNW/SW" or footage from lines CNE SE
Lease Owner West Supply Co., Inc.
Lease Name C. C. Crandall Well No. 2
Office Address Box 506 - Chase, Kansas
Character of Well (completed as Oil, Gas or Dry Hole) Oil Well
Date well completed September 22 19 42
Application for plugging filed September 15 19 55
Application for plugging approved September 20 19 55
Plugging commenced September 20 19 55
Plugging completed September 24 19 55
Reason for abandonment of well or producing formation Ceased production

If a producing well is abandoned, date of last production July 19 55
Was permission obtained from the Conservation Division or its agents before plugging was commenced? Yes

Name of Conservation Agent who supervised plugging of this well Ruel Durkee
Producing formation Arbuckle Depth to top 3746' Bottom 3767 1/2' Total Depth of Well 3767 1/2' Feet
Show depth and thickness of all water, oil and gas formations.

OIL, GAS OR WATER RECORDS

CASING RECORD

FORMATION	CONTENT	FROM	TO	SIZE	PUT IN	PULLED OUT
				8-5/8"	278'	None
				5-1/2"	3757'	3028'

Describe in detail the manner in which the well was plugged, indicating where the mud fluid was placed and the method or methods used in introducing it into the hole. If cement or other plugs were used, state the character of same and depth placed, from _____ feet to _____ feet for each plug set.

Filled the hole with sand from 3767 1/2' to 3750' and ran 6 sacks of cement. Mudded the hole to 260', setval 10' rock bridge and ran 15 sacks of cement at 250'. Mudded the hole to top and ran 5 sacks of cement to fill to base of cellar. Plugging completed.

(If additional description is necessary, use BACK of this sheet)
Name of Plugging Contractor West Supply Co., Inc.
Address Chase, Kansas

STATE OF Kansas, COUNTY OF Rice, ss.
Noel J. Knight (owner or operator) of the above-described well, being first duly sworn on oath, says: That I have knowledge of the facts, statements, and matters herein contained and the log of the above-described well as filed and that the same are true and correct. So help me God.

(Signature) Noel J. Knight
Chase, Kansas (Address)

SUBSCRIBED AND SWORN TO before me this 27th day of September 19 55
My commission expires May 20, 1957
Edward E. O'Brien Notary Public.

RECEIVED
STATE CORPORATION COMMISSION
SEP 23 1955
9-28-55
CONSERVATION DIVISION
Wichita, Kansas

PLUGGING
FILE SEC 14 T 23 R 10w
BOOK PAGE 50 LINE 15

WELL LOG BUREAU - KANSAS GEOLOGICAL SOCIETY
412 Union National Bank Bldg., Wichita, Kansas

15-155-62211-0000

SINCLAIR PRAIRIE OIL CO.,
Cecil Crandall No. 2

SEC. 14 T. 23 R. 10 W
ONE SE
660' f. Nth & 660' f. East lines SE $\frac{1}{4}$

Total Depth. 3767 $\frac{1}{2}$
Comm. 9-2-42 Comp. 9-22-42
Shot or Treated.
Contractor. Harbar Drlg. Co.
Issued. 10-31-42

County Rono.

CASING.

Rotary 3761
Cable 3767 $\frac{1}{2}$



85/8" 278' Cem.
5 $\frac{1}{2}$ " 3757' Cem.

Elevation. B.H.B. Ind.
Production Pot. 20,720 B.
no wtr 3000 B. Max.
Pot. after acid.

Figures Indicate Bottom of Formations.

surface clay	160
red bed sand & shells	220
shale & red bed	288
red bed	320
shale and shells	430
red bed	522
shale	618
shale and shells	1335
anhydrite	1375
lime	1655
sdv lime hard	1679
shale and lime	1876
lime	1925
shale and lime	1990
shale	2170
lime and shale	2405
shale and shells	2500
lime and shale	2690
lime shells	2765
lime	2965
shale	2986
lime and shale	3030
lime	3145
lime and shale	3210
lime	3240
lime and shale	3315
lime soft K. C.	3355
lime	3509
lime and shale	3560
shale	3585
whert	3619
lime	3624
shale	3745
lime	3767 $\frac{1}{2}$
Total Depth.	

no show of oil at T.D. until after acidized

Top Viola 3749

9-28-42 - Took test with btm hole bomb made ind.
potential 20,720 bbls oil, no water after 1000 gal acid

RECEIVED
CORPORATION COMMISSION

PLUGGING
FILE SEC 14 T 23 R 10 W
BOOK PAGE 150 LINE 15

SEP 26 1945
CONSERVATION DIVISION
Wichita, Kansas

Dunbar