


Give All Information Completely
Make Required Affidavit
Mail or Deliver Report to:
Conservation Division
State Corporation Commission
800 Ritzing Building
Wichita, Kansas

WELL PLUGGING RECORD

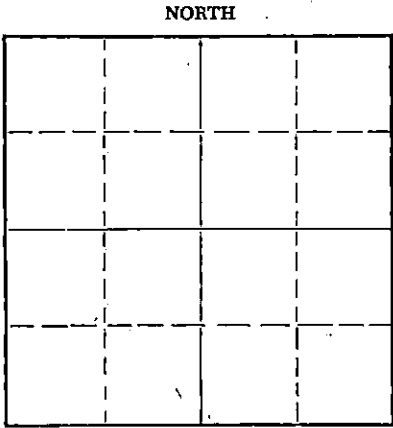

Locate well correctly on above
Section Plat

Reno County, Sec. 14 Twp. 23 Rge. 10 (E) W (W)
Location as "NE/CNW/SW" or footage from lines Gen. SE NE
Lease Owner. Cities Service Oil Company
Lease Name. Sentney Well No. 4
Office Address. Great Bend, Kansas
Character of Well (completed as Oil, Gas or Dry Hole) Oil Well
Date well completed. July 22, 19 42
Application for plugging filed. April 16, 19 56
Application for plugging approved. April 18, 19 56
Plugging commenced. May 23, 19 56
Plugging completed. May 31, 19 56
Reason for abandonment of well or producing formation. Depleted formation.

If a producing well is abandoned, date of last production. February 9, 19 56
Was permission obtained from the Conservation Division or its agents before plugging was commenced? Yes

Name of Conservation Agent who supervised plugging of this well. Ruel Durkee
Producing formation. Viola Depth to top. 3750 Bottom. 3772 Total Depth of Well. 3772 Feet
Show depth and thickness of all water, oil and gas formations.

OIL, GAS OR WATER RECORDS

CASING RECORD

FORMATION	CONTENT	FROM	TO	SIZE	PUT IN	PULLED OUT
				8-5/8"	192'	None
				5-1/2"	3757'	1596'

Describe in detail the manner in which the well was plugged, indicating where the mud fluid was placed and the method or methods used in introducing it into the hole. If cement or other plugs were used, state the character of same and depth placed, from _____ feet to _____ feet for each plug set.

3772-3745', river sand
3745-3697', 6 sacks cement
3697- 195', mud.
195- 145', 10' rock bridge and 15 sacks cement.
145- 12', mud.
12' to base of cellar, 5 sacks cement.

(If additional description is necessary, use BACK of this sheet)

Name of Plugging Contractor. Wilson, Inc. - Chas. D. Wilson, Oper.
Address. 2921 Bonita, Great Bend, Kansas

STATE OF Kansas, COUNTY OF Barton, ss.
F. T. Jones

(employee of owner) or (owner or operator) of the above-described well, being first duly sworn on oath, says: That I have knowledge of the facts, statements, and matters herein contained and the log of the above-described well as filed and that the same are true and correct. So help me God.

(Signature) F. T. Jones
Box 751, Great Bend, Kansas
(Address)

SUBSCRIBED AND SWORN TO before me this 5th day of June, 19 56

My commission expires April 24, 1957

Betty J. Sloan
Notary Public.

PLUGGING
FILE SEC. 14 T. 23 R. 10W
BOOK PAGE 54 LINE 26

JUN 6 1956
CONSERVATION DIVISION
Wichita, Kansas

6-6-56

WELL RECORD

Company Cities Service Oil Co. Well No. 4 Farm Sontroy
 Location 660' north and 660' west of E/4 Corner Sec. 14 T. 23 R. 10W
 Elevation 1760 County Reno State Kansas
 Drig. Comm. June 30, 1942 Contractor Corbett-Barbour Drilling Company
 Drig. Comp. July 22, 1942 Acid 500 gals. - July 25, 1942
 T. D. 3772' Initial Prod. B. H. P. Gauge Potential: 2820 oil, 180 water, 24 hrs.
(pump and flow)--(Ind. Cap. 16,548 bbls. fluid).

CASING RECORD:

8-5/8" @ 192' con. 150 sx Monarch & 100# G. C.
 5-1/2" @ 3757' con. 75 sx Cement

FORMATION RECORD:

sand & clay	0-40
sand & shale	135
red bed & shells	340
anhydrite	375
shale & shells	1350
lime & shale	1445
anhydrite	1475
broken lime	1600
shale & lime	1725
sand	1755
lime	1810
broken lime	1975
lime & shale	2075
lime with streaks of shale	2175
broken lime & shale	2250
shale & shells	2495
shale	2520
lime & shale	2660
lime	2710
broken lime	2750
lime	3055
lime & shale	3298
lime	3385
lime broken	3460
lime	3540
lime & shale	3580
chert	3595
chert & shale	3602
shale	3650
conglomerate	3700
shale	3761
chert & shale	3771

3771 Rot. TD = 3771 SIM
 dolomite

3772 T. D.

Top Viola 3750'
 Penetration 22'
 Total Depth 3772'

Loaded hole with 2500' water before Drilling-in.

Good show oil 3772-72, no fillup.

BYFO: 350' 00
 1000' 00
 1500' 00
 2250' 00
 2750' 00
 3500' 00

RECEIVED
 STATE COMMISSION
 JUL 23 1942
 OIL & GAS DIVISION

COND. STATE COMMISSION
 Wichita, Kansas

PLUGGING
 FILE SEC 14 T. 23 R. 10W
 BOX PAGE 54 LINE 26