


Give All Information Completely
Make Required Affidavit
Mail or Deliver Report to:
Conservation Division
State Corporation Commission
212 North Market, Insurance Bldg.
Wichita, Kansas

WELL PLUGGING RECORD

15-009-03044-0000

Barton County, Sec. 18 Twp. 16 Rge. (E) 11 (W)

Location as "NE/CNW/SW" or footage from lines NE NE NW
Lease Owner Great Bend Pipe & Supply
Lease Name Krier Well No. 8
Office Address Box 191, Great Bend, Kansas
Character of Well (completed as Oil, Gas or Dry Hole) _____
Date well completed _____ 19____
Application for plugging filed _____ 19____
Application for plugging approved _____ 19____
Plugging commenced 3-1-61 19____
Plugging completed 3-4-61 19____
Reason for abandonment of well or producing formation _____

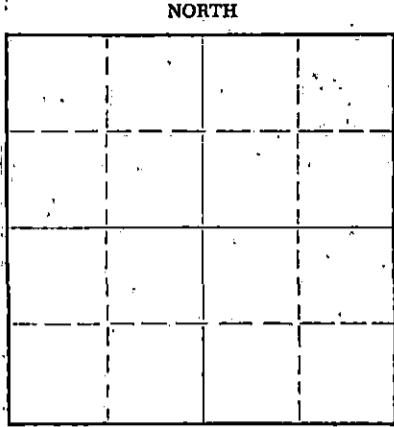

Locate well correctly on above Section Plat

If a producing well is abandoned, date of last production _____ 19____
Was permission obtained from the Conservation Division or its agents before plugging was commenced? yes

Name of Conservation Agent who supervised plugging of this well Donald Truan
Producing formation _____ Depth to top _____ Bottom _____ Total Depth of Well 3302 Feet
Show depth and thickness of all water, oil and gas formations.

OIL, GAS OR WATER RECORDS

CASING RECORD

FORMATION	CONTENT	FROM	TO	SIZE	PUT IN	PULLED OUT
				8 5/8"	280	none
				5 1/2"	3299	2539

Describe in detail the manner in which the well was plugged, indicating where the mud fluid was placed and the method or methods used in introducing it into the hole. If cement or other plugs were used, state the character of same and depth placed, from _____ feet to _____ feet for each plug set.

Plug had been set @ 3220
Top Perforation 3043'

Sanded hole to 3000'-dumped 5 sks cement-pulled casing-mudded hole to 290'-set 10' rock bridge-dumped 25 sks cement-mudded to 40'-set 10' rock bridge-dumped 10 sks cement.

RECEIVED
STATE CORPORATION COMMISSION
MAR 16 1961
03-16-61
CONSERVATION DIVISION
Wichita, Kansas

(If additional description is necessary, use BACK of this sheet)
Name of Plugging Contractor R & D Casing Pulling Co. License #236
Address Box 572, Hutchinson, Kansas

STATE OF Kansas, COUNTY OF Barton, ss.
Nathan Meltzer (employee of owner) or (owner or operator) of the above-described well, being first duly sworn on oath, says: That I have knowledge of the facts, statements, and matters herein contained and the log of the above-described well as filed and that the same are true and correct. So help me God.

(Signature) _____
Box 191, Great Bend, Kansas (Address)

SUBSCRIBED AND SWORN TO before me this 15th day of March, 19 61

3/30/61

My commission expires _____

Anne Meltzer
Anne Meltzer Notary Public.



NATIONAL COOPERATIVE RETIREMENT ASSOCIATION

GREAT BEND, KANSAS

OCTOBER 19, 1955

RECEIVED
STATE CORPORATION COMMISSION

APR 15 1961

TO: Gage W. Lee

FROM: C. R. Moore

SUBJECT: Request for approval to test Lansing zones in the Krier #8 well, located N^W NE NW, Section 18-16-11, Barton County, Kansas.

FEB 13 1961

CONSERVATION DIVISION
Wichita, Kansas

Ownership: NCRA - 100%

Elevation: 1961; 5 $\frac{1}{2}$ " casing set at 3299 (-1438) and cemented with 100 sacks.

Tops:	Lansing	3031 (-1170)
	Conglomerate	3278 (-1417)
	Arbuckle	3298 (-1437)

Total Depth: 3302 (-1441), well completed in the Arbuckle formation May 18, 1947, for an initial potential of 308 BOPD.