


FORMATION PLUGGING RECORD

Give All Information Completely
Make Required Affidavit
Mail or Deliver Report to:
Conservation Division
State Corporation Commission
800 Biting Building
Wichita, Kansas

NORTH

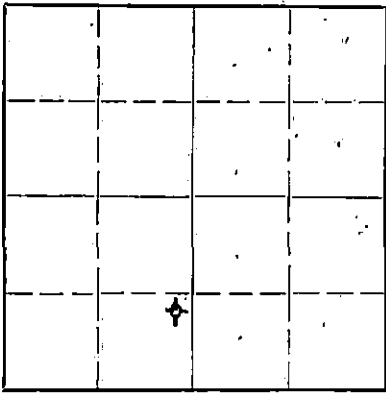

Locate well correctly on above Section Plat

Barton County, Sec. 18 Twp. 16 Rge. 11 (W)
Location as "NE $\frac{1}{4}$ NW $\frac{1}{4}$ SW $\frac{1}{4}$ " or footage from lines N.E. S.E. S.W.
Lease Owner M. B. Dancer
Lease Name Hoffmann Well No. 1
Office Address 7400th National Bank Building, 9200th
Character of Well (completed as Oil, Gas or Dry Hole) dry hole
Date well completed 4-10 1944
Application for plugging filed 4-11 1944
Application for plugging approved same day 1944
Plugging commenced 4-12 1944
Plugging completed 4-16 1944
Reason for abandonment of well or producing formation No. OIL WATER.

If a producing well is abandoned, date of last production 19
Was permission obtained from the Conservation Division or its agents before plugging was commenced? Yes

Name of Conservation Agent who supervised plugging of this well E. T. Alexander
Producing formation A.R.BUCKLE Depth to top 3365 Bottom 3386 Total Depth of Well 3386 Feet
Show depth and thickness of all water, oil and gas formations.


OIL, GAS OR WATER RECORDS

CASING RECORD

Formation	Content	From	To	Size	Put In	Pulled Out
<u>Sandy shale</u>	<u>Water & Baiter</u>	<u>175</u>	<u>190</u>	<u>12 1/2</u>	<u>435</u>	<u>435</u>
<u>Sandy shale</u>	<u>H.F. water</u>	<u>295</u>	<u>410</u>	<u>10</u>	<u>763</u>	<u>763</u>
<u>Sandy shale</u>	<u>8 Baiters</u>	<u>450</u>	<u>455</u>	<u>8</u>	<u>2490</u>	<u>2490</u>
<u>Sand</u>	<u>H.F. water</u>	<u>535</u>	<u>540</u>	<u>7.00</u>	<u>3090</u>	<u>3090</u>
<u>Sand</u>	<u>2 Baiters</u>	<u>1800</u>	<u>1815</u>			
<u>Sand</u>	<u>2 1/2 Baiters</u>	<u>2475</u>	<u>2485</u>			
<u>Sand</u>	<u>1 Baiter</u>	<u>2745</u>	<u>2755</u>			
<u>Sand</u>	<u>2 Baiter</u>	<u>3150</u>	<u>3160</u>			
<u>Sand</u>	<u>H.F. water</u>	<u>3380</u>	<u>3383.70</u>			

Describe in detail the manner in which the well was plugged, indicating where the mud fluid was placed and the method or methods used in introducing it into the hole. If cement or other plugs were used, state the character of same and depth placed, from _____ feet to _____ feet for each plug set.

Cemented with dump Baiter from 3380 to 3325 filled with mud, pulled 17" O.D. filled 8" with mud, pulled 8" filled 10" gravel cement, pulled 10" and near top 12 1/2" pulled up to 200 ft. Set Bridge at 225 filled with cement to 265. Set mud with dump Baiter put in mud, pulled 12 1/2" filled hole with mud. To 20 ft cement to 3 ft and soil to ground level.

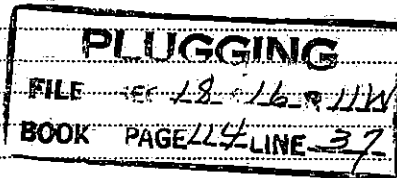

(If additional description is necessary, use BACK of this sheet)

Correspondence regarding this well should be addressed to M. B. Dancer
Address 7400th National Bank, Wichita, Kans

STATE OF Kansas, COUNTY OF Barton, ss.
Frank Wood (employee of owner) or (owner or operator) of the above-described well, being first duly sworn on oath, says: That I have knowledge of the facts, statements, and matters herein contained and the log of the above-described well as filed and that the same are true and correct. So help me God.

(Signature) Frank Wood

(Address) Wichita, Kansas

SUBSCRIBED AND SWORN to before me this 20 day of April, 1944

My commission expires April 25, 1946



VERNON OIL & GAS COMPANY
214 Fourth National Bank Building
Wichita, Kansas.

COMPANY: M. B. Armer & Vernon Oil & Gas Co.
COUNTY: Barton 18 - 16 - 11W
LOCATION: NE SE SW
FARM: Tony Hoffman - No. 1 'B'
COMMENCED: 1-20-44
COMPLETED: 3-29-44
ELEVATION: 1906

PIPE RECORD
13-3/8" 435
10" 763
8" 2505
7" 3090

Cellar	10	Lime	2470
Shale -1/2 BW	175	Shale 2 1/2 BW 2475-85	2475
Sandy Shale	280	Sand	2485
Red Rock - HFW 295-310	295	Shale	2500
Sand	410	Lime	2510
Shale - 8BW 45-55	465	Shale	2525
Sandy Shale	480	Lime	2530
Shale HFW 535-40	510	Shale	2535
Red Rock	725	Lime	2560
Red Rock - T. Anhydrite	753	Shale Shells	2600
Lime	785	Shale	2640
Red Rock	980	Lime	2690
Shale	1200	Shale - 1BWPH 2745-55	2700
Salt	1420	Lime (T. Topeka 2710)	2825
Shale Shells	1520	Shale	2830
Lime	1580	Lime	2860
Shale	1585	Shale	2870
Lime	1610	Lime	2970
Shale	1645	Shale	2995
Lime	1670	Lime	3000
Shale	1675	Red Rock	3007
Lime	1725	Shale	3060
Lime Broken	1770	Lime	3065
Lime - 2BW 1800-15	1815	Shale (T. Lansing)	3075
Shale	1825	Lime	3105
Lime	1870	Shale	3110
Red Rock	1875	Lime (SSO 3150-60 & 2 BW)	3115
Lime	1880	Lime (SSO 3230-35)	3285
Shale Shells	1925	(VSSL 3350-52)	
Red Rock	1930	Shale	3290
Lime	1950	Lime	3344
Red Rock	1957	Lime	3346
Lime	1965	Red, shale & chert	3350
Shale	1970	Sand (T. Cherty Cong. 3348)	3355
Red Rock	1975	Red Rock & Chert	3360
Lime	2025	Conglomerate	3365
Shale	2030	(T. Arbuckle 3365)	
Lime	2043	Arbuckle Lime	3380
Red Rock	2063	Lime	3383 - T. D.
Lime	2085	(SS Hvy. black oil 3368-71) D & A	
2085 equals 2097 Corr.			
Broken Lime	2100		
Shale	2125		
Lime Shale	2145		
Red Rock	2155		
Lime	2170		
Shale	2185		
Lime	2200		
Shale Shells	2290		
Shale	2320		
Lime	2335		
Shale Shells	2375		
Shale	2390		
Lime	2395		
Shale Shells	2400		
Shale	2415		
Red Rock	2445		
Shale	2455		
Lime	2465		
Shale	2465		

PLUGGING
 FILE REC 18 16R 11W
 BOOK PAGE 114 LINE 37

STATE OF KANSAS
APR 22 1944
COMMISSIONER OF DEPARTMENT OF REVENUE

STATE OF KANSAS)
COUNTY OF SEDGWICK) SS

I hereby certify that the above is a true and correct copy of the log, as kept by the drillers, of the Tony Hoffman No. 1, located in the NE SE SW of Section 18-16-11W, Barton County, Ks.

O. R. Vickery
Subscribed and sworn to before me this 19th day of April, 1944.

J. E. Seigh
Notary Public

My comm expires: 3-15-1947