


WELL PLUGGING RECORD

OR 15-009-06491-0000
Strike out upper line when reporting plugging of formations.

~~FORMATION PLUGGING RECORD~~

Give All Information Completely
Make Required Affidavit
Mail or Deliver Report to:
Conservation Division
State Corporation Commission
800 Bittling Building
Wichita, Kansas

NORTH

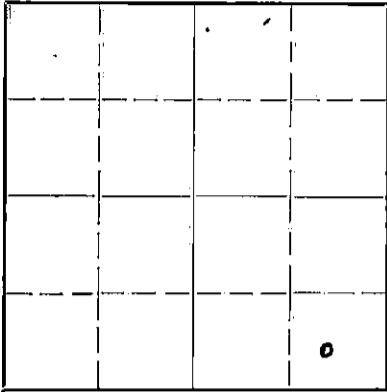

Locate well correctly on above Section Plat

Barton County, Sec. 18 Twp. 16 Rge. (E) 11 (W)
Location as "NE $\frac{1}{4}$ NW $\frac{1}{4}$ SW $\frac{1}{4}$ " or footage from lines SE $\frac{1}{4}$, SE $\frac{1}{4}$, 554 ft fm Sth & West lines.
Lease Owner Sinclair Prairie Oil Co
Lease Name Martha Edwards Well No. 2
Office Address Box 521, Tulsa, Okla.
Character of Well (completed as Oil, Gas or Dry Hole) dry hole
Date well completed Nov. 13, 1943 19
Application for plugging filed verbally Nov. 15, 1943 19
Application for plugging approved " 19
Plugging commenced Nov. 15, 1943 19
Plugging completed Nov. 16, 1943 19
Reason for abandonment of well or producing formation dry hole completion

If a producing well is abandoned, date of last production - 19
Was permission obtained from the Conservation Division or its agents before plugging was commenced? Yes, verbal with field representative

Name of Conservation Agent who supervised plugging of this well C.T. Alexander
Producing formation Arbuckle-objective Depth to top 3398 Bottom Total Depth of Well 3405 Feet
Show depth and thickness of all water, oil and gas formations.



OIL, GAS OR WATER RECORDS

CASING RECORD

Formation	Content	From	To	Size	Put In	Pulled Out
Topeka	dry	Top 2700		9"OD	315	0
Len-Kc	slight oil show	" 3060				
Conglomerate		Top 3327				
Arbuckle	dry	" 3398				

Describe in detail the manner in which the well was plugged, indicating where the mud fluid was placed and the method or methods used in introducing it into the hold. If cement or other plugs were used, state the character of same and depth placed, from feet to feet for each plug set.

3405- 315 mud
315- 275 wood plug & 15 sx cement
275- 26 mud
26- 6 wood plug & 15 sx cement
6- 0 mud

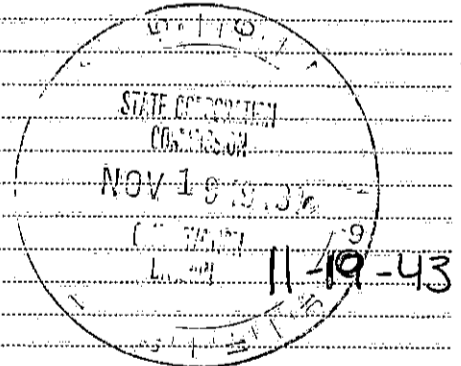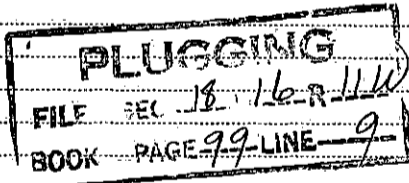

(If additional description is necessary, use BACK of this sheet)

Correspondence regarding this well should be addressed to Victor Chancellor
Address Box 774, Great Bend, Kans.

STATE OF Kansas, COUNTY OF Barton, ss.
I., Victor Chancellor (employee of owner) or (owner or operator) of the above-described well, being first duly sworn on oath, says: That I have knowledge of the facts, statements, and matters herein contained and the log of the above-described well as filed and that the same are true and correct. So help me God.

(Signature) Victor Chancellor

(Address)

SUBSCRIBED AND SWORN to before me this 17th day of November, 1943
J.M. Mad Jaresae Notary Public.

My commission expires 6-14-47

Sinclair Prairie Oil Co.

Well Log

Martha Edwards # 2
 SE/4, SE/4, Sec. 18-18-11W Barton Co. Kans.
 554' fm Sth & West lines.
 Elev. 1894'

Harbar Drilling Co. -Contr.
 Rotary tools.
 Began drlg Oct. 28, 1943.
 Completed drlg Nov. 13, 1943.
 Dry hole.. TD. 3405' in Arbuckle

Drillers Log

Surface soil	50
Sand & Shells	145
Sandy Shale	180
Lime Shells, hard-broken	280
Shale & Shells	326
Set 9" OD @ 315 ft w/125 sx cmt.	
Cement & Course Sand	480
Shells	540
Shale	630
Red Bed-Shale	735
Anhydrite	760
Shale	765
Red Bed & Shale	1055
Shale & Shells	1220
Salt & Shells	1365
Shale	1400
Lime-Shale-Shells	1445
Lime	1475
Shale-Lime Shells	1575
Lime	1610
Shale & Shells	1620
Lime	1695
Sandy Shale	1745
Sand	1755
Lime-hard	1805
Shale & Shells	1875
Lime & Shale	1905
Broken lime & Shale	1995
Shale & Lime	2060
Lime	2095
Shale - Shells	2340
Shale	2415
Shale	2500
Lime & Shells	2550
Lime-broken	2570
Shale	2725
Lime & Chert	2730
Shale & Lime	2740
Lime	2830
Lime-hard	2860
Lime	2890
Lime-broken	2905
Lime	2920
Lime-broken	2970
Lime	3405 TD



Top Topeka 2700
 Top Lan-Kc 3060 Base 3320' slight oil show 3227-3232'
 Top Conglomerate 3327'
 Top Arbuckle 3398' dry hole.
 Above meas. all from derrick floor.
 Deduct 8 1/2' for meas. from surface level.

PLUGGING
 FILE 18-16-11W
