

WELL PLUGGING RECORD

OR 15-009-06493-0000
FORMATION PLUGGING RECORD

Strike out upper line when reporting plugging of formations.

Give All Information Completely
Make Required Affidavit
Mail or Deliver Report to:
Conservation Division
State Corporation Commission
808 Bittling Building
Wichita, Kansas

Barton County, Sec. 18 Twp. 16 Rge. 11 (E) (W)

Location as "NE $\frac{1}{4}$ NW $\frac{1}{4}$ SW $\frac{1}{4}$ " or footage from lines NW-NW-NE

Lease Owner Solar Oil Corp.

Lease Name Schartz Well No. 9

Office Address 1117 Union Natl. Bank, Wichita, Kansas

Character of Well (completed as Oil, Gas or Dry Hole) Dry Hole

Date well completed July 14 1947 19

Application for plugging filed July 14 1947 19

Application for plugging approved July 14 1947 19

Plugging commenced July 14 1947 19


Plugging completed July 14 1947 19

Reason for abandonment of well or producing formation Dry Hole

Arbuckle lime

If a producing well is abandoned, date of last production 19

Was permission obtained from the Conservation Division or its agents before plugging was commenced? Yes

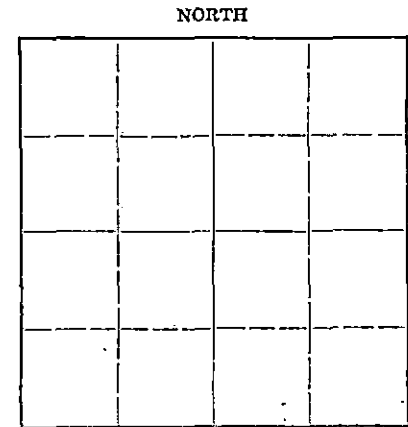

Locate well correctly on above Section Plat

Name of Conservation Agent who supervised plugging of this well H.W. Kerr

Producing formation Arbuckle lime Depth to top 3312 Bottom 3316 Total Depth of Well 3316 Feet

Show depth and thickness of all water, oil and gas formations.

OIL, GAS OR WATER RECORDS

CASING RECORD

Formation	Content	From	To	Size	Put In	Pulled Out
				85/8	723'	None
					Cemented w/ 300 sks.	

Describe in detail the manner in which the well was plugged, indicating where the mud fluid was placed and the method or methods used in introducing it into the hole. If cement or other plugs were used, state the character of same and depth placed, from feet to feet for each plug set.

Gunned and mixed up mud in the pits, filled hole to 500' with mud, set bridging plug at 500', put 15 sacks of mixed cement thru drill pipe on top of plug. filled hole with mud from 455' to 35', set bridging plug at 35', filled surface to Base of cellar using 10 sacks of cement.

JUL 19 1947 07-19-47

(If additional description is necessary, use BACK of this sheet.)

Correspondence regarding this well should be addressed to Charles H. Keevert, or Solar Oil Corp.
Address ~~1022-2222~~ 1117 Union Natl. Bank, Wichita, Kansas

STATE OF Kansas, COUNTY OF Sedgwick, ss.

Charles H. Keevert (employee of owner) or (owner or operator) of the above-described well,

being first duly sworn on oath, says: That I have knowledge of the facts, statements, and matters herein contained and the log of the above-described well as filed and that the same are true and correct. So help me God.

(Signature) Charles H. Keevert

(Address)

SUBSCRIBED AND SWORN to before me this 18th day of July, 19 47

My commission expires Oct. 31, 1949

(Notary Public)

PLUGGING
FILE SEC 18 T 16 R 44
BOOK PAGE 120 LINE 34

WELL LOG

BRACK DRILLING COMPANY
205 Brown Building
Wichita, Kansas

Solar Oil Corporation

NW/4 NW/4 NE/4 Section 18-16S-11W,
Barton County, Kansas

Schartz No. 9

TOTAL DEPTH:

Comm: 6-30-47

Comp. 7-15-47

cellar	5
rock	40
lime, shells, clay	150
lime, shells, shale	316
sand, shale & shells	510
shale & shells	715
anhydrite	720
anhydrite	723
sand	745
red bed & shale	870
shale, salt, shells	1415
shale & shells	1620
lime & shale	1700
lime & shale	1915
lime	2030
lime	2130
lime, shale	2140
shale & shells	2385
shale	2590
shale, shells	2665
lime & shale	2735
lime & shale	2808
lime	2880
lime & shale	2933
shale & lime	3021
lime	3095
lime	3065
lime	3205
lime	3278
lime & chert	3297
lime, chert	3316
TOTAL DEPTH	3316

WITNESS

Frederic B. Alcorn


DATED: July 16, 1947

To the best of my knowledge the above is a true and correct record of the formations and depths at which found.

BRACK DRILLING COMPANY

By:

Wm. H. Brack

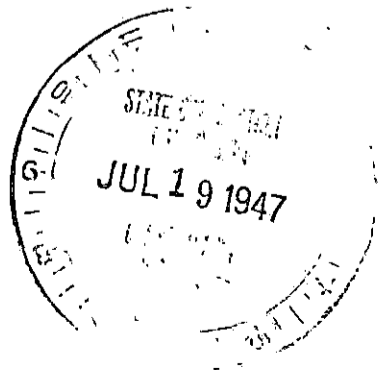

PLUGGING
FILE SEC 18 1/4 R 11W
BOOK PAGE 20 LINE 34