


Give All Information Completely
Make Required Affidavit
Mail or Deliver Report to:
Conservation Division
State Corporation Commission
800 Bittling Building
Wichita, Kansas

NORTH

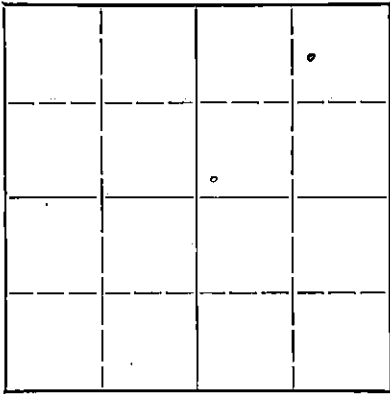

Locate well correctly on above Section Plat

Barton County. Sec. 18 Twp. 16 Rge. 11 (W)
Location as "NE 1/4 NW 1/4 SW 1/4" or footage from lines. SW 1/4 SW 1/4 NE 1/4

Lease Owner. Solar Oil Company
Lease Name. K. Schartz Lease Well No. 12
Office Address. 1117 Union Nat'l. Bank Building, Wichita 2, Ks.
Character of Well (completed as Oil, Gas or Dry Hole). Dry Hole
Date well completed. Jan. 31, 1953 19
Application for plugging filed. Feb. 4, 1953 19
Application for plugging approved. Feb. 4, 1953 19
Plugging commenced. Feb. 4, 1953 19
Plugging completed. Feb. 4, 1953 19
Reason for abandonment of well or producing formation

If a producing well is abandoned, date of last production 19
Was permission obtained from the Conservation Division or its agents before plugging was commenced? Yes

Name of Conservation Agent who supervised plugging of this well. Charles Stough
Producing formation. Depth to top. Bottom. Total Depth of Well. 3321 Feet
Show depth and thickness of all water, oil and gas formations.

OIL, GAS OR WATER RECORDS

CASING RECORD

Formation	Content	From	To	Size	Put In	Pulled Out
				8 5/8"	701.30	None

Describe in detail the manner in which the well was plugged, indicating where the mud fluid was placed and the method or methods used in introducing it into the hold. If cement or other plugs were used, state the character of same and depth placed, from 3321 feet to surface feet for each plug set.

Gun pits for heavy mud and circulate
Set Plug at 300' - 1/2 sack of hulls and 20 sacks cement.
Mud to 35' of base of cellar - set plug - 1/2 sack hulls and 10 sacks cement to base of cellar.

CONFIDENTIAL
02-18-53

(If additional description is necessary, use BACK of this sheet)

Correspondence regarding this well should be addressed to. Solar Oil Company
Address. 1117 Union National Bank Building, Wichita 2, Kansas

STATE OF KANSAS, COUNTY OF SEDGWICK, ss.


(employee of owner) or (owner or operator) of the above-described well, being first duly sworn on oath, says: That I have knowledge of the facts, statements, and matters herein contained and the log of the above-described well as filed and that the same are true and correct. So help me God.

(Signature) James Davis, Jr.
Wichita, Kansas
(Address)

SUBSCRIBED AND SWORN to before me this February 19 1953

Leta Lee Miller
Notary Public.

My commission expires July 27, 1955

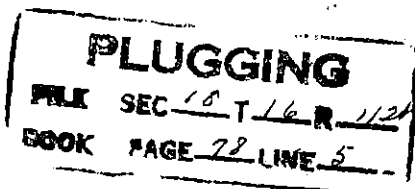

SCHARTZ #12

SW SW NE of Section 18-16S-11W Barton County, Kansas

Rigged up Rotary Tools 1/20/53
Tore Down Rotary Tools 2/4/53

Run 23 Jts. (702') of 8 5/8" 8 Rd Thd
Surface Pipe set at 700'. Cemented
with 325 sacks cement and 3 sacks of
Cal. Cl.

<u>FORMATION</u>	<u>FROM</u>	<u>TO</u>
Earth & shale	0'	156'
Shale & sand	156	240
Shale & shells	240	428
Sand	428	465
Shale & Redbed	465	692
Anhydrite	692	723
Shale & shells	723	1120
Salt	1120	1170
Shale & shells	1170	1500
Lime & shale	1500	1725
Lime	1725	2005
Lime & shale streaks	2005	2150
Shale, lime & sand	2150	2327
Shale & sand	2327	2408
Lime & shale streaks	2408	2586
Lime & shale	2586	2675
Lime	2675	2700
Lime & shale	2700	2819
Lime	2819	2884
Lime, shale & sand	2884	2972
Lime	2972	3170
Lime & shale streaks	3170	3229
Lime	3229	3275
Lime & shale	3275	3297
Lime	3297	3321 TD

I, June Swaney, do hereby certify that the foregoing log is true and correct, to the best of my knowledge and belief.

June Swaney

Subscribed and sworn to before me this 13th day of February, 1953.

Warren H. Kopke

My commission expires: September 24, 1955

PLUGGING
FILE SEC 18 T 16 R 112
BOOK PAGE 28 LINE 5