


STATE OF KANSAS
STATE CORPORATION COMMISSION

15-009 -07126-
WELL PLUGGING RECORD 0000

Give All Information Completely
Make Required Affidavit
Mail or Deliver Report to:
Conservation Division
State Corporation Commission
211 No. Broadway
Wichita, Kansas

Barton County. Sec. 18 Twp. 16 Rge. 11 (E) (W)
Location as "NE/CNW/SW" or footage from lines C-SW/2
Lease Owner Great Bend Pipe and Supply Co.
Lease Name Hoffman Well No. C-2
Office Address West 10th-Box 411, Great Bend, Kansas
Character of Well (completed as Oil, Gas or Dry Hole) _____
Date well completed _____ 19____
Application for plugging filed Yes 19____
Application for plugging approved Yes 19____
Plugging commenced 11-7 1957
Plugging completed 11-12 1957
Reason for abandonment of well or producing formation _____

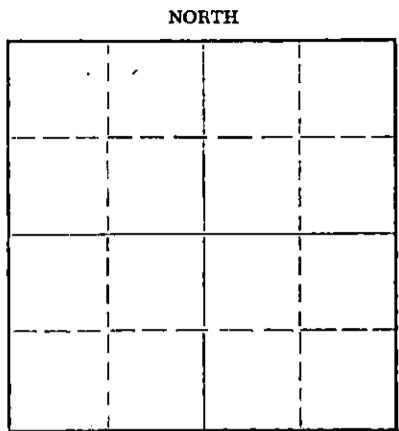

Locate well correctly on above Section Plat

If a producing well is abandoned, date of last production _____ 19____
Was permission obtained from the Conservation Division or its agents before plugging was commenced? Yes

Name of Conservation Agent who supervised plugging of this well Mr. R.M. Brundedge
Producing formation _____ Depth to top _____ Bottom _____ Total Depth of Well 3335' Feet
Show depth and thickness of all water, oil and gas formations.

OIL, GAS OR WATER RECORDS

CASING RECORD

FORMATION	CONTENT	FROM	TO	SIZE	PUT IN	PULLED OUT
				5 1/2"		2,522'

Describe in detail the manner in which the well was plugged, indicating where the mud fluid was placed and the method or methods used in introducing it into the hole. If cement or other plugs were used, state the character of same and depth placed, from _____ feet to _____ feet for each plug set.

Measured into T.D. 3335'.
Plugging started 11-7-57. Finished 11-12-57.
Plugged off bottom with sand to 2900' and dumped 5 sacks cement.
Shot 5 1/2" casing at 2,522'. Spotted oil. Plugged well with mud to 300'.
Set rock bridge and dumped 10 sacks. Mudded to 40' and mixed 10 sacks.
for cap on well. Well completed.

STATE CORP. COM. DIVISION
NOV 20 11-29-57

(If additional description is necessary, use BACK of this sheet)
Name of Plugging Contractor J.O. Forbes d/b/a Forbes Casing Pulling Co.
Address Box 221, Great Bend, Kansas

STATE OF Kansas, COUNTY OF Barton, ss.
J.O. Forbes (employee of owner) or (owner or operator) of the above-described well, being first duly sworn on oath, says: That I have knowledge of the facts, statements, and matters herein contained and the log of the above-described well as filed and that the same are true and correct. So help me God.

(Signature) J.O. Forbes
Box 221, Great Bend, Kansas
(Address)

SUBSCRIBED AND SWORN TO before me this 15th day of November, 1957
Betty S. Edman
Notary Public.
My commission expires November 8, 1960.

PLUGGING
FILE SEC 18 T. 16 R. 11 W
BOOK PAGE 58 LINE 20

WELL LOG

Company - N.C.R.A.
Contractor - Flournoy and Williams

Hoffman C #2
C W/2 SE SW 18-16-11
Barton County, Kansas

Comm. 1-30-50
Comp. 2-9-50

Casing: 345' 8-5/8"
3334' 5-1/2" w/125 sax

Bottom of Formations

Surface	10
Shale and shells	75
Sand	90
Shale and shells	127
Sand	145
Shale and shells	365
Sand, Shale and shells	520
Red Bed and shells	758
Anhydrite	787
Shale and shells	1675
Sandy shale	1695
Shale and lime shells	2700
Lime	3005
Lime and shale	3070
Lime	3334
Arbuckle Lime	3335 T.D. Rotary

A F F I D A V I T

STATE OF KANSAS)

(SS:)

COUNTY OF SEDGWICK)

Chester Williams, of lawful age, being first duly sworn on his oath, states that the above formations and depths are true and correct as taken from the daily drilling log of the Hoffman C #2 well located in the C W/2 SE SW 18-16-11, Barton County, Kansas.

Subscribed and sworn to before me this 25th day of February, 1950.

Notary Public, STATE CORPORATE

My commission expires Nov. 3, 1952

PLUGGING

FILE SEC 18 T 16 R 11W

BOOK PAGE 58 LINE 20

NOV 1
CONS...