


STATE OF KANSAS
STATE CORPORATION COMMISSION

Give All Information Completely
Make Required Affidavit
Mail or Deliver Report to:
Conservation Division
State Corporation Commission
211 No. Broadway
Wichita, Kansas

15-009-19256-0000
WELL PLUGGING RECORD

NORTH

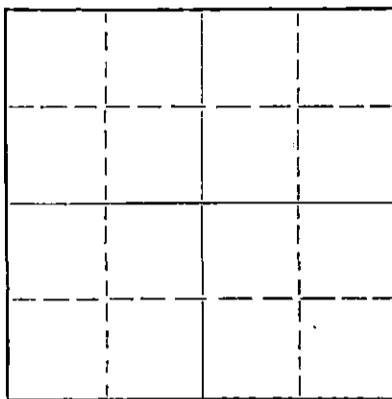

Locate well correctly on above
Section Plat

Barton County. Sec. 18 Twp. 16 Rge. (E) 111 (W)
Location as "NE/CNW/SW" or footage from lines NE - SW - SW
Lease Owner Great Bend Pipe & Supply
Lease Name Hoffman "C" Well No. 1
Office Address Great Bend, Kansas
Character of Well (completed as Oil, Gas or Dry Hole) _____
Date well completed _____ 19____
Application for plugging filed _____ 19____
Application for plugging approved _____ 19____
Plugging commenced _____ 10-23 19 58
Plugging completed _____ 10-27 19 58
Reason for abandonment of well or producing formation _____

If a producing well is abandoned, date of last production _____ 19____
Was permission obtained from the Conservation Division or its agents before plugging was commenced? Yes

Name of Conservation Agent who supervised plugging of this well Donald Truan
Producing formation _____ Depth to top _____ Bottom _____ Total Depth of Well _____ Feet
Show depth and thickness of all water, oil and gas formations.

OIL, GAS OR WATER RECORDS

CASING RECORD

FORMATION	CONTENT	FROM	TO	SIZE	PUT IN	PULLED OUT
				8 5/8	312	None
				5 1/2	332 1/2	2795.44

Describe in detail the manner in which the well was plugged, indicating where the mud fluid was placed and the method or methods used in introducing it into the hole. If cement or other plugs were used, state the character of same and depth placed, from _____ feet to _____ feet for each plug set.

Sanded to 3180' - dumped 5 sks cement - mudded to 300' - set 10' rock bridge - dumped 20 sks cement - mudded to 40' - set 10' rock bridge - dumped 10 sks cement.

RECORDED
STATE CORPORATION COMMISSION

DEC 17 1958 12-17-58

CONSERVATION DIVISION
Wichita, Kansas

(If additional description is necessary, use BACK of this sheet)
Name of Plugging Contractor R & D Casing Pulling Company License # 236
Address Box 569 Ellinwood, Kansas

STATE OF Kansas COUNTY OF Barton, ss.
Nathan Melzer (employee of owner) or (owner or operator) of the above-described well, being first duly sworn on oath, says: That I have knowledge of the facts, statements, and matters herein contained and the log of the above-described well as filed and that the same are true and correct. So help me God.

(Signature) Nathan Melzer
Box 191, Gr. Bend, Kansas (Address)



SUBSCRIBED AND SWORN TO before me this 16th day of December, 19 58

My commission expires 3/30/61 Nathan Melzer Notary Public.

PLUGGING
FILE SEC. 18 T. 16 R. 11W
BOOK PAGE 137 LINE 44

File Hoffman C-1 #1

WELL LOG

OWNER - National Coop. Refinery Ass'n Hoffman C-1

NE SW SW
Sec. 18-16-11
Barton County, Kans.

Comm. 11-1-49
Compl. 11-11-49

Casing: 312' 8-5/8"
3324' 5-1/2"

Formations	Depth
Surface	20
Post Rock	55
Shale and shells	225
Sand	240
Shale and shells	312
Sand, Blue shale	450
Red Bed and shale	752
Anhydrite	781
Shale and shells	1185
Shale and salt	1405
Shale and shells	1885
Lime	2020
Shale and Lime	2680
Broken Lime	2750
Lime	3328

S/W

REGISTERED
STATE OF KANSAS
APR 3 1953
CONSERVATION DIVISION
Wichita, Kansas

STATE OF KANSAS }
COUNTY OF SEDGWICK } SS:

I, Chester Williams, of lawful age, being first duly sworn, deposes and states that the above formations and depths are true and correct as shown on the daily drilling log of the Hoffman C-1 well in the NE SW SW Sec. 18-16-11W, Barton County, Kansas.

Chester Williams

Subscribed and sworn to before me this 21st day of November, 1949.

W. L. Bass
Notary Public

My commission expires Nov. 3, 1952

PLUGGING
FILE SEC. 18 T. 16 R. 11W
BOOK PAGE 137 LINE 44