


WELL PLUGGING RECORD

Give All Information Completely
Make Required Affidavit
Mail or Deliver Report to:
Conservation Division
State Corporation Commission
211 No. Broadway
Wichita, Kansas

Finnery County. Sec. 3 Twp. 22S Rge. 3 (E) 34 (W)
Location as "NE/CNWxSWx" or footage from lines NW NW
Lease Owner KIMBARK OPERATING CO.
Lease Name McCanles Well No. 1
Office Address 1860 Lincoln #808, Denver, Co. 80203
Character of Well (completed as Oil, Gas or Dry Hole) Dry
Date well completed 6/11/19 76
Application for plugging filed 19
Application for plugging approved 19
Plugging commenced 6/11/19 76
Plugging completed 6/11/19 76
Reason for abandonment of well or producing formation _____

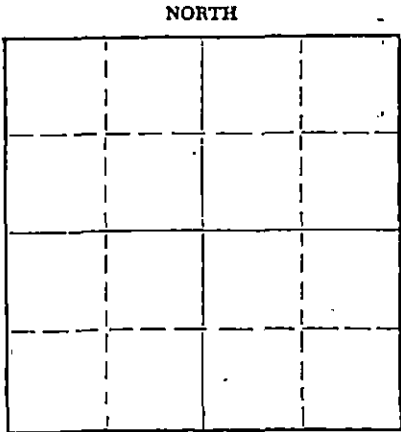

Locate well correctly on above Section Plat

If a producing well is abandoned, date of last production _____ 19____
Was permission obtained from the Conservation Division or its agents before plugging was commenced? Yes

Name of Conservation Agent who supervised plugging of this well Clarence Thomas
Producing formation _____ Depth to top _____ Bottom _____ Total Depth of Well _____ Feet
Show depth and thickness of all water, oil and gas formations.

OIL, GAS OR WATER RECORDS

CASING RECORD

FORMATION	CONTENT	FROM	TO	SIZE	PUT IN	PULLED OUT
				8 5/8	315	0

Describe in detail the manner in which the well was plugged, indicating where the mud fluid was placed and the method or methods used in introducing it into the hole. If cement or other plugs were used, state the character of same and depth placed, from _____ feet to _____ feet for each plug set.

500'-5 sacks cement
300'-35 sacks cement
40'-0'-10' sacks cement
RAT Hole 5 sacks cement
Hole filled with mud.

8-2-76

Name of Plugging Contractor Gabbert-Jane (Additional description is necessary, use BACK of this sheet)
Address Wichita, Kansas

STATE OF _____, COUNTY OF _____, ss. _____ (employee of owner) or (owner or operator) of the above-described well, being first duly sworn on oath, says: That I have knowledge of the facts, statements, and matters herein contained and the log of the above-described well as filed and that the same are true and correct. So help me God.

(Signature) [Signature]

SUBSCRIBED AND SWORN TO before me this 30th day of July, 19 76

My commission expires Mar 6, 1978 [Signature] Notary Public.

GABBERT-JONES, INC.
WICHITA, KANSAS
DRILLERS' WELL LOG

McCanles #1
C-NW-NW Sec 3-22S-34W
Finney County Kansas

Commenced: 5-27-76

Completed: 6-11-76

OPERATOR: KIMBARK

Depth From	to	Formation	Remarks
0	126	Sand-Native Clay	
126	327	Dry Drill	Ran 319' of 8 5/8" csg set @
327	753	Shale	315' Cemented w/200 sks Cement
753	1342	Shale-Gyp	2 Baskets - 115' & 112' Cemented
1342	1922	Shale-Gyp-Sand	w/100 sks down Back Side
1922	2474	Shale	Plug Down @ 12:00 p.m. 5-28-76
2474	2616	Shale-Lime	
2616	2808	Sahle & Lime stks	
2808	3525	Lime	
3525	3710	Lime-Sand-Shells	
3710	3856	Lime	
3856	4187	Lime-Shale	
4187	4356	Lime	
4356	4400	Lime-Shale	
4400	4450	Lime-Shale Stks	
4450	4499	Lime	
4499	4542	Lime-Shale	
4542	4670	Lime	
4670	4775	Lime-Shale	
4775	4842	Lime	
	4842 - TD		DRY & ABANDONED

RECEIVED
COMMISSION
JUN 2 1976
COMMISSION DIVISION
Wichita, Kansas

STATE OF KANSAS)
) SS
COUNTY OF SEDGWICK)

I, the undersigned, being duly sworn on oath, state that the above Drillers Log is true and correct to the best of my knowledge and belief and according to the records of this office.

[Signature]

GABBERT-JONES, INC.

[Signature]
JAMES S. SUTTON II

Suscribed and sworn to before me this 17th day of June, 1976.

[Signature]
ELIZABETH J. EDWARDS-NOTARY PUBLIC

My Commission Expires February 6, 1979.

