


Give All Information Completely
Make Required Affidavit
Mail or Deliver Report to:
Conservation Division
State Corporation Commission
800 Bitting Building
Wichita, Kansas

WELL PLUGGING RECORD

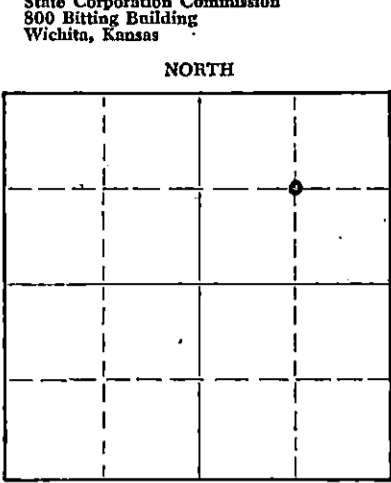

Locate well correctly on above Section Plat

Finney County. Sec. 5 Twp. 22 Rge. 34 (X) W (W)
Location as "NE/CNW&SW" or footage from lines G-NE/1
Lease Owner Petroleum, Inc.
Lease Name Barlow Gas Unit Well No. 1
Office Address 311 East Third, Wichita, Kansas
Character of Well (completed as Oil, Gas or Dry Hole) Dry hole
Date well completed January 21 19 55
Application for plugging filed January 27 19 56
Application for plugging approved January 30 19 56
Plugging commenced February 13 19 56
Plugging completed February 14 19 56
Reason for abandonment of well or producing formation No producible zones

If a producing well is abandoned, date of last production - - - - 19 - -
Was permission obtained from the Conservation Division or its agents before plugging was commenced? Yes

Name of Conservation Agent who supervised plugging of this well Gordan Farr
Producing formation - - - Depth to top - - - Bottom - - - Total Depth of Well 2,628 Feet
Show depth and thickness of all water, oil and gas formations.

OIL, GAS OR WATER RECORDS

CASING RECORD

| FORMATION | CONTENT | FROM | TO | SIZE | PUT IN | PULLED OUT |
|-------------------|----------------|--------|--------|--------|--------|------------|
| Herington-KRIDER- | water & little | | | | | |
| Winfield | gas | 2,562' | 2,628' | 8-5/8" | 285' | None |
| | | | | 5-1/2" | 2,562' | 950' |
| | | | | | | |
| | | | | | | |
| | | | | | | |
| | | | | | | |
| | | | | | | |

Describe in detail the manner in which the well was plugged, indicating where the mud fluid was placed and the method or methods used in introducing it into the hole. If cement or other plugs were used, state the character of same and depth placed, from _____ feet to _____ feet for each plug set.

Filled hole with crushed rock from 2,628' to 2,557' and placed 5 sacks cement on top of rock. Mudded up to 280', and made solid rock bridge on top of mud. Placed 15 sacks cement on top of rock bridge, mudded up to 35', and built solid rock bridge, and filled hole to base of well cellar with 10 sacks cement.

(If additional description is necessary, use BACK of this sheet)

Name of Plugging Contractor Morgan Well Plugging Service
Address 102 West 18th Street, Hutchinson, Kansas

STATE OF KANSAS, COUNTY OF BARTON, ss.
C. J. Wiltse (employee of owner) or (owner or operator) of the above-described well, being first duly sworn on oath, says: That I have knowledge of the facts, statements, and matters herein contained and the log of the above-described well as filed and that the same are true and correct. So help me God.

(Signature) C. J. Wiltse
(Address) _____

SUBSCRIBED AND SWORN TO before me this 27 day of February, 19 56
Roy E. Anderson Notary Public.

My commission expires November 21, 1957

PLUGGING
FILE SEC 5 TWP 22 R 34 W
BOOK PAGE 35 LINE 9

FEB 29 1956 . 2-29-56
CONSERVATION DIVISION
Wichita, Kansas

WELL LOG

COMPANY **Petroleum, Inc.**

SEC. 5 T. 22 R. 34W

FARM **BARLOW GAS UNIT**

NO. 1

LOC. C NE/4

TOTAL DEPTH **2627'**

COUNTY **Finney County, Kansas**

COMM. **December 30, 1954.**

COMP. **January 4, 1955.**

CONTRACTOR **Garvey Drilling Company**



CASING **8-5/8" @ 285' w/200 sax.
5 1/2" @ 2562' w/550 sax.**

ELEVATION **2988' RB**

PRODUCTION **Herington**

FIGURES INDICATE BOTTOM OF FORMATIONS

Tops:

| | |
|------|---------------------|
| 120 | Surface Soil & Clay |
| 135 | Sand |
| 286 | Sand & Clay |
| 730 | Shale |
| 780 | Sand |
| 980 | Shale |
| 1375 | Shale & Red Bed |
| 1395 | Anhydrite |
| 1710 | Red Bed & Shale |
| 2345 | Shale & Shells |
| 2610 | Lime & Shale |
| 2627 | Lime |
| 2627 | RTD |

| | |
|-------------|-------------|
| Hollenberg: | 2530 (-158) |
| Herington: | 2566 (+122) |
| Krider: | 2578 (+110) |
| Winfield: | 2611 (+377) |

State of KANSAS
 County of SEDGWICK

PLUGGING
 FILE SEC 5 T. 22 R. 34W
 BOOK PAGE 35 LINE 9

I, Karl E. Becker of Petroleum, Inc.

upon oath state that the above and foregoing is a true and correct copy of the log of the BARLOW UNIT #1 well.

Karl E. Becker VED

Subscribed and sworn to before me this 17th day of February, 19 55

My Commission Expires: 8-11-58

[Signature]
NOTARY PUBLIC