

STATE OF KANSAS  
STATE CORPORATION COMMISSION

Give All Information Completely  
Make Required Affidavit  
Mail or Deliver Report to:  
Conservation Division  
State Corporation Commission  
211 No. Broadway  
Wichita, Kansas

WELL PLUGGING RECORD

Finney County. Sec. 24 Twp. 22S Rge. 34W (E) (W)

Location as "NE/CNW/SW" or footage from lines 50' S & W of C of Section

Lease Owner The Texas Company

Lease Name Bump-Miller Unit Well No. 1

Office Address 614 Bitting Building, Wichita, Kansas

Character of Well (completed as Oil, Gas or Dry Hole) Gas

Date well completed February 23 19 54

Application for plugging filed July 29 19 57

Application for plugging approved July 30 19 57


Plugging commenced August 5 19 57

Plugging completed August 6 19 57

Reason for abandonment of well or producing formation Well never connected due to high water production & non-commercial gas prod.

If a producing well is abandoned, date of last production \_\_\_\_\_ 19 \_\_\_\_\_

Was permission obtained from the Conservation Division or its agents before plugging was commenced? Yes

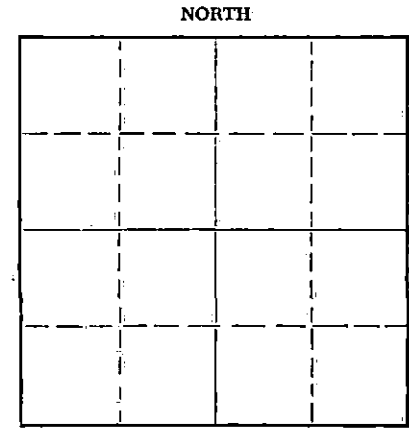

Locate well correctly on above Section Plat

Name of Conservation Agent who supervised plugging of this well M. C. Rives

Producing formation Hugoton Series Depth to top 2556 Bottom 2578 Total Depth of Well 2655 Feet

Show depth and thickness of all water, oil and gas formations. PBTD 2535

OIL, GAS OR WATER RECORDS

CASING RECORD

FORMATION	CONTENT	FROM	TO	SIZE	PUT IN	PULLED OUT
				10-3/4"	505'	None
				7"	2659'	?

Describe in detail the manner in which the well was plugged, indicating where the mud fluid was placed and the method or methods used in introducing it into the hole. If cement or other plugs were used, state the character of same and depth placed, from \_\_\_\_\_ feet to \_\_\_\_\_ feet for each plug set.

- 2535' to 2510' - 5 Sacks Cement
- 2510' to 400' - Heavy Mud
- 400' to 390' - Rock Bridge
- 390' to 370' - 5 Sacks Cement
- 370' to 40' - Heavy Mud
- 40' to surface - 10 Sacks Cement

Name of Plugging Contractor R & S Pipe Pulling Company  
Address Box 192, Ellinwood, Kansas

STATE OF Kansas COUNTY OF Sedgwick ss. Gene R. Bates (employee of owner) or (owner or operator) of the above-described well, being first duly sworn on oath, says: That I have knowledge of the facts, statements, and matters herein contained and the log of the above-described well as filed and that the same are true and correct. So help me God.

(Signature) Gene R. Bates  
614 Bitting Building, Wichita, Kansas  
(Address)

SUBSCRIBED AND SWORN TO before me this 6th day of August 19 57

My commission expires September 20, 1960

H. Howard Kistler  
Notary Public.

PLUGGING  
FILE SEC 24 T. 22 R. 34W  
BOOK PAGE 32 LINE 10

RECEIVED  
STATE CORPORATION COMMISSION  
8-8-57  
AUG 8 1957  
CONSERVATION DIVISION  
Wichita, Kansas

File

# LOG OF WELL

Form PO-214 Sheet 1 (6-53)ESM

BUMP-MILLER UNIT NO. 1

SHEET 1

OWNER The Texas Company DIVISION Oklahoma DATE MADE March 12, 1954  
 DISTRICT Kansas LEASE Bump-Miller Unit WELL NO. 1  
 STATE Kansas COUNTY OR PARISH Finney TWP. 22S RANGE 34W SEC. 24  
 LOCATION OF WELL 50' S. & 50' W. of center of section

COMMENCED RIGGING UP 2-2-54 COMMENCED DRILLING 2-2-54 COMPLETED DRILLING 2-23-54  
 DAY DRILLER \_\_\_\_\_ NIGHT DRILLER \_\_\_\_\_ CONTRACTOR Stickle Drlg. Co.  
 CABLE FROM \_\_\_\_\_ TO \_\_\_\_\_ ROTARY FROM 0' TO 2655' COMPANY RIG NO. \_\_\_\_\_  
 TOTAL DEPTH 2655' MEASURED BY M. C. Harrell ELEVATION KB - 2925  
DF - 2922  
GL - 2920

PBTD 2587'

## CASING RECORD

SIZE	WEIGHT	PUT IN WELL		PULLED OUT		LOST IN WELL		SHOES		PACKERS		SET BY
		FEET	INS.	FEET	INS.	FEET	INS.	LENGTH	MAKE	KIND	LENGTH	
10-3/4"	29#	505'				(R-3, SW, new casing)						PT.
7"	20#	2659'				(J-55, new casing)						PT.
												PT.
												PT.
												PT.
												PT.
10-3/4" casing set at 501' with 375 sacks cement, 1% CC. Cement circulated.												PT.
7" casing set at 2654' with 800 sacks cement. Cement circulated.												PT.

WAS CASING CEMENTED? \_\_\_\_\_ IF SO, HOW MANY SACKS OF CEMENT USED? \_\_\_\_\_  
 LINER: STATE SIZE AND WEIGHT \_\_\_\_\_ WHERE SET \_\_\_\_\_ FT. AND INS. \_\_\_\_\_ FT. AND INS. \_\_\_\_\_  
 HOW PUT TOGETHER \_\_\_\_\_ COUPLING \_\_\_\_\_ FLUSH-JOINT \_\_\_\_\_ INSERTED \_\_\_\_\_  
 REMARKS: \_\_\_\_\_

## EQUIPMENT RECORD

TUBING				SUCKER RODS			PUMPING OUTFIT
SIZE	WEIGHT	FEET	INS.	FEET	INS.	SIZE AND KIND	DESCRIPTION, KIND, SIZE, ETC.
Completed Testing 3-5-54							

FLOWING, PUMPING, GASSEY OR DRY Gasser PRODUCTION FIRST 24 HOURS 223 MCFGPD & 75 GWPB PRODUCTION SETTLED \_\_\_\_\_  
 IF GAS WELL, OPEN FLOW CAPACITY \_\_\_\_\_ SHUT IN PRESSURE \_\_\_\_\_ ROCK PRESSURE \_\_\_\_\_  
 KIND OF SHOT \_\_\_\_\_ SIZE OF SHOT, QUARTZ \_\_\_\_\_  
 NUMBER OF SHELLS \_\_\_\_\_ SIZE OF SHELLS \_\_\_\_\_ INCHES, DIAMETER \_\_\_\_\_  
 LENGTH OF SHELLS \_\_\_\_\_ FEET \_\_\_\_\_ INCHES \_\_\_\_\_ TOP OF SHOT \_\_\_\_\_  
 BOTTOM OF SHOT \_\_\_\_\_ ANCHOR \_\_\_\_\_ WELL BRIDGED TO \_\_\_\_\_  
 TOTAL DEPTH OF WELL \_\_\_\_\_ NUMBER OF SHOT \_\_\_\_\_ PRODUCTION BEFORE SHOT \_\_\_\_\_ BBL. PER DAY \_\_\_\_\_  
 PRODUCTION AFTER SHOT \_\_\_\_\_ BBL. PER DAY. SHOT FURNISHED BY \_\_\_\_\_  
 NAME OF SHOOTER \_\_\_\_\_ SHOT INSPECTED \_\_\_\_\_ BY \_\_\_\_\_ (COMPANY EMPLOYEE)  
 COMMENCED DRILLING DEEPER \_\_\_\_\_ COMPLETED \_\_\_\_\_ DRILLING DEEPER \_\_\_\_\_

TOTAL DEPTH \_\_\_\_\_ PRODUCTION FIRST 24 HOURS \_\_\_\_\_ PRODUCTION SETTLED \_\_\_\_\_  
 REMARKS: \$340; \$550; \$500 Bump-Miller Unit #1  
Hugoton Pool  
TD 2655' - PBTD 2587'  
Completed Drilling 2-23-54  
Completed Testing 3-5-54

NOTE: IF WELL WAS DRY, STATE UNDER REMARKS, WHEN, HOW, AND BY WHOM PLUGGED.  
 STATE UNDER REMARKS ANYTHING OF INTEREST NOT COVERED IN LOG.  
 IF THE SPACE PROVIDED FOR REMARKS IS NOT SUFFICIENT, WRITE ON BOTTOM OF LAST SHEET OF LOG

**PLUGGING**  
 FILE SEC 24 T. 22 R. 34W  
 BOOK PAGE 32 LINE 10

TOTAL NUMBER OF SHEETS \_\_\_\_\_  
 W. H. H. & K. O. H. H.

The Texas Company  
Tulsa, Oklahoma

Tulsa, Oklahoma  
February 9, 1954

CONTRACTOR: Stickle Drilling Company  
Drilling Commenced: February 2, 1954  
Drilling Completed: February 7, 1954

~~Garden City Gas Unit~~ "A" #1  
SW of Center of Section 24-  
22S-34W, Finney Co., Kansas

DRILLERS LOG

Sand & Clay	0-110
Shale & Shells	110-1025
Red Bed	1025-1150
Shale & Shells	1150-2040
Shale & Lime	2040-2515
Lime & Shale	2515-2595
Shale & Lime	2595-2655 TD

I, Frank E. Stickle hereby certify the above to be a true and complete Drillers Log of The Texas Company's Garden City Gas Unit "A" #1 SW of Center of Section 24-22S-34W, Finney County, Kansas.

Frank E. Stickle  
Frank E. Stickle

Lillian T. Bowham  
Notary Public

February 13, 1956  
My Commission Expires

