


STATE OF KANSAS  
STATE CORPORATION COMMISSION

WELL PLUGGING RECORD

Give All Information Completely  
Make Required Affidavit  
Mail or Deliver Report to  
Conservation Division  
State Corporation Comm.  
245 North Water  
Wichita, KS 67202

Kearny County. Sec. 4 Twp 22S Rge. 35 X/W  
Location as "NE/CNW $\frac{1}{2}$ SW $\frac{1}{2}$ " or footage from lines 100'E C E/2 W/2  
Lease Owner J. A. Allison  
Lease Name Rooney 'B' Well No. 3  
Office Address 300 W. Douglas, Suite 305, Wichita, Ks.  
Character of Well (Completed as Oil, Gas or Dry Hole) 67202  
dry hole

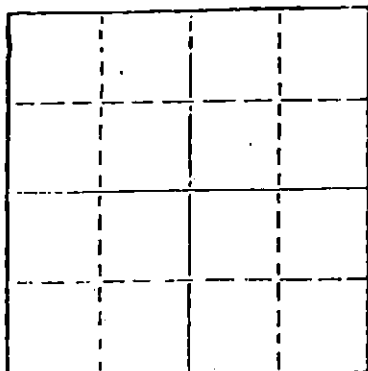

Locate well correctly on above  
Section Plat

Date Well completed 9-1 1979  
Application for plugging filed 9-1 1979  
Application for plugging approved 9-1 1979  
Plugging commenced 9-1 1979  
Plugging completed 9-1 1979  
Reason for abandonment of well or producing formation no commercial quantities of oil or gas encountered  
If a producing well is abandoned, date of last production -- 19

Was permission obtained from the Conservation Division or  
its agents before plugging was commenced? yes

Name of Conservation Agent who supervised plugging of this well Gilbert Balthazor  
Producing formation \_\_\_\_\_ Depth to top \_\_\_\_\_ Bottom \_\_\_\_\_ Total Depth of Well 4575  
Show depth and thickness of all water, oil and gas formations.

OIL, GAS OR WATER RECORDS

CASING RECORD

FORMATION	CONTENT	FROM	TO	SIZE	PUT IN	PULLED OUT
surface hole	shale	surf	304'	8-5/8"	294	none

Describe in detail the manner in which the well was plugged, indicating where the mud fluid was placed and the method or methods used in introducing it into the hold. If cement or other plugs were used, state the character of same and depth placed, from \_\_\_\_\_ feet to \_\_\_\_\_ feet for each plug set.

Fluid to 550', plug, 70 sx  
Fluid to 250', plug, 20 sx  
Fluid to 40', plug, 10 sx

RECEIVED  
STATE CORPORATION COMMISSION

SEP 11 1979

(If additional description is necessary, use BACK of this sheet) CONSERVATION DIVISION  
Wichita, Kansas

Name of Plugging Contractor D N B DRILLING, INC.

515 R. H. Garvey Building

STATE OF Kansas Wichita, Kansas 67202 COUNTY OF Sedgwick, ss.

Ella Priess (employee of owner) or (owner or operator)  
of the above-described well, being first duly sworn on oath, says: That I have knowledge of the facts, statements, and matters herein contained and the log of the above-described well as filed and that the same are true and correct. So help me God.

(Signature)

Ella Priess

515 R.H. Garvey Bldg., Wichita, Ks. 67202  
(Address)

SUBSCRIBED AND SWORN TO before me this \_\_\_\_\_ day of \_\_\_\_\_, 19

My commission expires April 30, 1983

Dorothy L. Schmidt  
Dorothy L. Schmidt Notary Public.

DOROTHY L. SCHMIDT  
STATE NOTARY PUBLIC  
Sedgwick County, Kansas  
My Appt. Exp. April 30, 1983

DRILLER'S LOG

J. A. ALLISON  
 No. 3 Rooney 'B'  
 100'E C E/2 W/2  
 Sec. 4-22S-35W  
 Kearny Co., Ks.

Commenced: 8-22-79  
 Completed: 9-1-79

Surface Casing: 294' of 8-5/8"  
 cemented w/275 sx common, 2% gel,  
 3% cc

FORMATIONDEPTH

Surface Hole	0 - 304
Shale & Sand	304 - 715
Shale	715 - 1660
Sand & Shale	1660 - 2121
Anhydrite	2121 - 2136
Shale	2136 - 3353
Shale & Lime	3353 - 3545
Shale	3545 - 3730
Shale & Lime	3730 - 3933
Lime & Shale	3933 - 4065
Shale & Lime	4065 - 4325
Lime & Shale	4325 - 4439
Shale	4439 - 4463
Lime & Sand	4463 - 4555
Lime & Shale	4555 - 4575 RTD

RECEIVED  
 STATE CORPORATION COMMISSION

SEP 11 1979

CONSERVATION DIVISION  
 Wichita, Kansas

I do hereby certify that the foregoing statements are true and correct to the best of my knowledge and belief.

D N B DRILLING, INC.

*Ella Priess*

Ella Priess

STATE OF KANSAS: ss:

Subscribed and sworn to before me this 6th day of September, 1979.

*Dorothy L. Schmidt*

Dorothy L. Schmidt, Notary Public

DOROTHY L. SCHMIDT  
 STATE NOTARY PUBLIC  
 Sedgwick County, Kansas  
 My Appl. Exp. April 30, 1983