

STATE OF KANSAS
STATE CORPORATION COMMISSION

WELL PLUGGING RECORD

Give All Information Completely
Make Required Affidavit
Mail or Deliver Report to:
Conservation Division
State Corporation Commission
211 No. Broadway
Wichita, Kansas

Kearny County, Sec. 4 Twp. 22 Rge. 35 (E) W (W)

Location as "NE/CNW/SW" or footage from lines. C NW NW

Lease Owner The Boyard Supply Company

Lease Name Rooney Well No. 1

Office Address Tulsa, Oklahoma

Character of Well (completed as Oil, Gas or Dry Hole) _____

Date well completed _____ 19__

Application for plugging filed _____ 19__

Application for plugging approved _____ 19__


Plugging commenced 10-23-63 _____ 19__

Plugging completed 10-24-63 _____ 19__

Reason for abandonment of well or producing formation Depleted.

If a producing well is abandoned, date of last production _____ 19__

Was permission obtained from the Conservation Division or its agents before plugging was commenced? yes

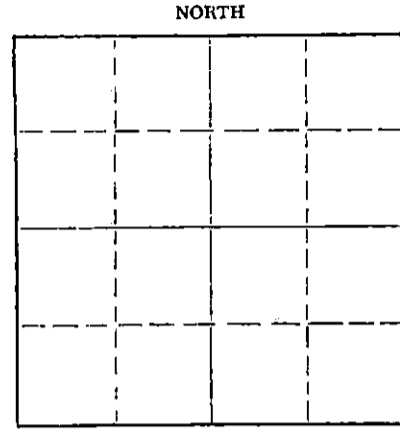

Locate well correctly on above Section Plat

Name of Conservation Agent who supervised plugging of this well Hugh Scott

Producing formation _____ Depth to top _____ Bottom _____ Total Depth of Well 5085' Feet

Show depth and thickness of all water, oil and gas formations.

OIL, GAS OR WATER RECORDS

CASING RECORD

FORMATION	CONTENT	FROM	TO	SIZE	PUT IN	PULLED OUT
				8-5/8"	823'	None
				4-1/2"	4599'	2244'

Describe in detail the manner in which the well was plugged, indicating where the mud fluid was placed and the method or methods used in introducing it into the hole. If cement or other plugs were used, state the character of same and depth placed, from _____ feet to _____ feet for each plug set.

Checked hole to 4599', sanded to 4450' and dumped 10 sacks of cement @ 4450' with dump bailer. Pulled 4 1/2" casing to 800' and pumped in 35 sacks of cement. Mudded to 50', ~~and~~ set rock bridge to 40' and capped with 15 sacks of cement.

RECEIVED
STATE CORPORATION COMMISSION

OCT 31 1963 10-31-63

CONSERVATION DIVISION
Wichita, Kansas

PLUGGING COMPLETE.

(If additional description is necessary, use BACK of this sheet)

Name of Plugging Contractor KNIGHT CASING PULLING COMPANY

Address CHASE, KANSAS

STATE OF KANSAS, COUNTY OF RICE, ss.

Noel J. Knight (employee of owner) or ~~(owner)~~ of the above-described well, being first duly sworn on oath, says: That I have knowledge of the facts, statements, and matters herein contained and the log of the above-described well as filed and that the same are true and correct. So help me God.

(Signature) Noel J. Knight

Chase, Kansas

(Address)

SUBSCRIBED AND SWORN TO before me this 28th day of October, 1963

My commission expires May 20, 1964

Milton J. Volin
Notary Public.



Sec. 4 Twp. 22 S. Rge. 35 W.

660'	X	Iron bar and lath with red flag.	

County Kearny County, Kansas

FEE OWNER W.T.Reevey No.1

LEASE OWNER Prime Drilling Co.

CONTRACTOR _____

LOCATION C NW 1/4, Section 4, Twp. 22 S. - Rge. 35 W.

ELEVATION _____

DATE August 8, 1963

LOCATION MADE BY: J. E. Watson

REMARKS: I hereby certify that the well location was measured and staked as shown by this plat.

J. E. Watson

J. E. Watson
 Civil Engineer
 License No. 779
 Box 1182
 Ulysses, Kansas

RECEIVED
STATE CORPORATION COMMISSION

NOV 8 1963

CONSERVATION DIVISION
Wichita, Kansas

ROTARY DRILLING LOG

OWNER: S. Keith Tuthill
 CONTRACTOR: Prime Drilling Company
 LEASE: Rooney #1
 LOCATION: C NW NW Sec. 4-22S-35W
 Kearney County, Kansas

CASING: Set 8 5/8" surface casing
 @ 823', 425 sx HA-5 Pozmix.

0 - 91	Sand & Clay
91 - 625	Sand, Shale & Shells
625 - 930	Shale
930 - 1830	Red Bed
1830 - 2320	Shale & Lime Streaks
2320 - 2810	Shale & Lime
2810 - 3100	Lime & Shale
3100 - 3218	Shale & Lime
3218 - 3300	Lime & Shale
3300 - 3360	Lime
3360 - 3472	Shale & Lime
3472 - 4080	Lime & Shale
4080 - 5085	Lime
5085	Rotary Total Depth

RECEIVED
 STATE CORPORATION COMMISSION
 NOV 8 1963
 CONSERVATION DIVISION
 Wichita, Kansas

Ran 4 1/2" casing @ 4599',
 100 sx salt saturated common,
 DV Tool 2900', 140 sx Pozmix

We certify that the above log is true and correct to the best of our knowledge and belief.

PRIME DRILLING COMPANY

BY L. J. Clampitt
 L. J. Clampitt

ROTARY DRILLING LOG

OWNER: S. Keith Tuthill
 CONTRACTOR: Prime Drilling Company
 LEASE: Rooney #1
 LOCATION: C NW NW Sec. 4-22S-35W
 Kearney County, Kansas

CASING: Set 8 5/8" surface casing
 @ 823', 425 sx HA-5 Pozmix.

0 - 91	Sand & Clay
91 - 625	Sand, Shale & Shells
625 - 930	Shale
930 - 1830	Red Bed
1830 - 2320	Shale & Lime Streaks
2320 - 2810	Shale & Lime
2810 - 3100	Lime & Shale
3100 - 3218	Shale & Lime
3218 - 3300	Lime & Shale
3300 - 3360	Lime
3360 - 3472	Shale & Lime
3472 - 4080	Lime & Shale
4080 - 5085	Lime
5085	Rotary TD

RECEIVED
 STATE CORPORATION COMMISSION

OCT 14 1963

CONSERVATION DIVISION
 Wichita, Kansas

Ran 4 1/2" Casing @ 4599, 100 sx salt saturated com.
 DV Tool 2900', 140 sx Pozmix