

15-009-00681-0000


WELL PLUGGING RECORD

STATE OF KANSAS
 STATE CORPORATION COMMISSION
 Give All Information Completely
 Make Required Affidavit
 Mail or Deliver Report to:
 Conservation Division
 State Corporation Commission
 800 Bittling Building
 Wichita, Kansas

Barton County, Sec. 23 Twp. 16 Rge. 11 (E) 11 (W)

Location as "NE/CNW/SW" or footage from lines SE SE SW
 Lease Owner Derby Drilling Company
 Lease Name Disque Well No. 1
 Office Address 352 N. Broadway, Wichita 2, Kansas
 Character of Well (completed as Oil, Gas or Dry Hole) Dry
 Date well completed December 2 19 49
 Application for plugging filed December 2 19 49
 Application for plugging approved December 7 19 49
 Plugging commenced December 2, 19 49
 Plugging completed December 2 19 49
 Reason for abandonment of well or producing formation Dry

NORTH

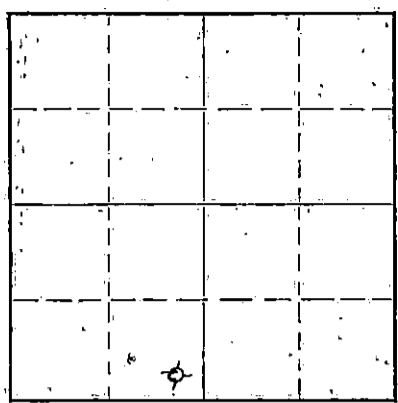

Locate well correctly on above
 Section Plat.

If a producing well is abandoned, date of last production 19
 Was permission obtained from the Conservation Division or its agents before plugging was commenced? Yes In field 12-2-49

Name of Conservation Agent who supervised plugging of this well C. D. Stough
 Producing formation Arbuckle Depth to top 3390 Bottom 3440 Total Depth of Well 3440 TD Feet
 Show depth and thickness of all water, oil and gas formations.

OIL, GAS OR WATER RECORDS

CASING RECORD

Formation	Content	From	To	Size	Put In	Pulled Out
Soil, shale and sand	Water	0	183	8-5/8"	183	None
Shale, sand and lime	water	183	3340	5-1/2	None	

Describe in detail the manner in which the well was plugged, indicating where the mud fluid was placed and the method or methods used in introducing it into the hole. If cement or other plugs were used, state the character of same and depth placed, from _____ feet to _____ feet for each plug set.

3440 to 183 Heavy mud
183 to 123 15 sacks cement
123 to 70 Heavy mud
70 to 6 10 sacks cement
6 to 0 Soil

RECORDED
12-9-49
 DEC 9 - 1949
 STATE CORPORATION COMMISSION

(If additional description is necessary, use BACK of this sheet) **KANSAS**

Correspondence regarding this well should be addressed to Derby Drilling Company
 Address 352 North Broadway
Wichita 2, Kansas


STATE OF Kansas COUNTY OF Sedgwick ss:
M. S. Davis (employee of owner) or (owner or operator) of the above-described well,
 being first duly sworn on oath, says: That I have knowledge of the facts, statements, and matters herein contained and the log of the above-described well as filed and that the same are true and correct. So help me God.

(Signature) M. S. Davis
352 No. Broadway Wichita 2, Kans
 (Address)

SUBSCRIBED AND SWORN to before me this 8th day of December, 19 49
Debra Karnish
 Notary Public.

My commission expires 12-18-49

22-5133-s 9-48-10M

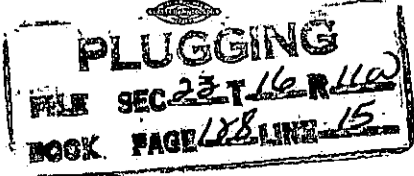

15-009-00681-0000

DERBY DRILLING COMPANY
352 NORTH BROADWAY
WICHITA, KANSAS

Derby Drilling Company, et al
Production Department
Wichita, Kansas

Disque #1
SE SE SW $\frac{1}{4}$, 23-16-11W
Barton County, Kansas

Elevation: 1912 D. F.
Spudded: November 22, 1949
Rotary Completed: December 2, 1949
Cable Tools Completed: None
Acid Treatment: None
Initial Production: D & A
Contractor: Derby Drilling Company

CASING RECORD

183' 8-5/8" 2-1/2" Seamless, cemented with 125 sacks cement
5-1/2" None

DRILLERS LOG

Soil, shale & sand 0 to 170
Shale 205
Sand 305
Broken lime 335
Shale & lime 725
Anhydrite 753
Shale & shells 1265
Shale & lime 1900
Lime 2115
Lime & shale 2335

Shale & shells 2335 to 2515
Shale 2617
Lime 3341
Lime & shale 3370
Chert 3391
Lime 3440 E.D.

Note 3470 E.D., 3438 D.F.

DEC 9 - 1949
STATE REGISTRATION
COMMISSION
KANSAS

STATE OF KANSAS)
COUNTY OF SEDGWICK) ss

I hereby certify that to the best of my knowledge and belief, the foregoing log is true and correct.

PLUGGING
FILE SEC. 23-T-168-114
BOOK PAGE 128 LINE 15

DERBY DRILLING COMPANY

By _____

Subscribed and sworn to before me, a Notary Public, in and for the State and County aforesaid this _____ day of _____, 19____.

Lucia Larnish
Notary Public

My Commission Expires 1/18/49