

15-009-30083-0000


STATE OF KANSAS
STATE CORPORATION COMMISSION

WELL PLUGGING RECORD

Give All Information Completely
Make Required Affidavit
Mail or Deliver Report to
Conservation Division
State Corporation Comm.
245 North Water
Wichita, KS 67202

Barton County. Sec. 23 Twp. 16 Rge. 11 E/W
Location as "NE/CNW $\frac{1}{4}$ SW $\frac{1}{4}$ " or footage from lines
SE NE SW

Lease Owner Brougner Oil, Inc.
Lease Name Burmeister #1 Well No. _____
Office Address Great Bend, Kansas 67530
Character of Well (Completed as Oil, Gas or Dry Hole) _____

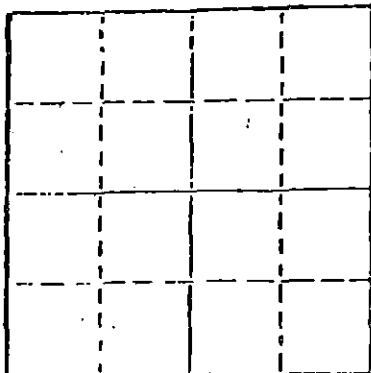

Locate well correctly on above Section Plat

Date Well completed _____ 19____
Application for plugging filed _____ 19____
Application for plugging approved _____ 19____
Plugging commenced 3/31/80 _____ 19____
Plugging completed 4/16/80 _____ 19____
Reason for abandonment of well or producing formation
depleted.
If a producing well is abandoned, date of last production _____ 19____

Was permission obtained from the Conservation Division or its agents before plugging was commenced? yes _____

Name of Conservation Agent who supervised plugging of this well Rankin
Producing formation _____ Depth to top _____ Bottom _____ Total Depth of Well 3377'
Show depth and thickness of all water, oil and gas formations.

OIL, GAS OR WATER RECORDS

CASING RECORD

FORMATION	CONTENT	FROM	TO	SIZE	PUT IN	PULLED OUT
				8-5/8	225	none
				5 1/2"	3370	2210

Describe in detail the manner in which the well was plugged, indicating where the mud fluid was placed and the method or methods used in introducing it into the hold. If cement or other plugs were used, state the character of same and depth placed, from _____ feet to _____ feet for each plug set.

Sanded to 3200' and ran 5 sacks cement. Loaded hole, shot pipe at 2414', 2309', 2211', pulled 67 joints. Pumped 4 sacks hulls, 25 sacks gel, 2 sacks hulls and 100 sacks cement.

PLUGGING COMPLETE.

STATE RECEIVED
APR 28 1980
CONSERVATION DIVISION
WICHITA, KANSAS

(If additional description is necessary, use BACK of this sheet)

Name of Plugging Contractor KELSO CASING PULLING
CHASE, KANSAS

STATE OF KANSAS COUNTY OF RICE, ss.
R. DARRELL KELSO (employee of owner) or (owner or operator)
of the above-described well, being first duly sworn on oath, says: That I have knowledge of the facts, statements, and matters herein contained and the log of the above-described well as filed and that the same are true and correct. So help me God.

(Signature) R. Darrell Kelso
CHASE, KANSAS
(Address)

SUBSCRIBED AND SWORN TO before me this 25th day of April, 19 80

Margaret Melcher
Notary Public.

My commission expires _____

