


WELL PLUGGING RECORD

Give All Information Completely
Make Required Affidavit
Mail or Deliver Report to:
Conservation Division
State Corporation Commission
211 No. Broadway
Wichita, Kansas

Reno County, Sec. 12 Typ. 23 Rge. 10 (E) W (W)

Location as "NE/CNW/SW" or footage from lines CN 72 NW SW
Lease Owner West Supply Co., Inc.
Lease Name Weideroder #3 Well No. _____
Office Address Chase, Kansas
Character of Well (completed as Oil, Gas or Dry Hole) _____
Date well completed _____ 19____
Application for plugging filed _____ 19____
Application for plugging approved _____ 19____
Plugging commenced 3-31-58 19____
Plugging completed 4-5-58 19____
Reason for abandonment of well or producing formation _____

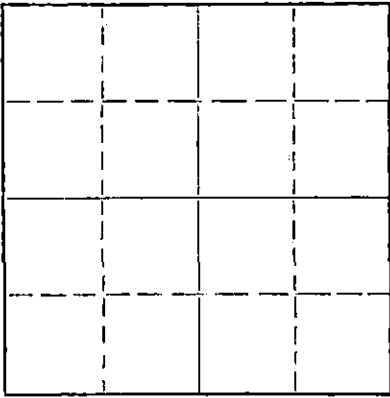

Locate well correctly on above Section Flat

If a producing well is abandoned, date of last production _____ 19____
Was permission obtained from the Conservation Division or its agents before plugging was commenced? yes

Name of Conservation Agent who supervised plugging of this well Fred Hampel
Producing formation _____ Depth to top _____ Bottom _____ Total Depth of Well 3765 Feet
Show depth and thickness of all water, oil and gas formations.

OIL, GAS OR WATER RECORDS

CASING RECORD

FORMATION	CONTENT	FROM	TO	SIZE	PUT IN	PULLED OUT
				8-5/8"	327'	none
				5-1/2"	3759'	2990'

Describe in detail the manner in which the well was plugged, indicating where the mud fluid was placed and the method or methods used in introducing it into the hole. If cement or other plugs were used, state the character of same and depth placed, from _____ feet to _____ feet for each plug set.

Checked the hole to 3765' and found it open.
Filled w/sand to 3740' and ran 5 sacks of cement. Pulled casing to 1700' and circulated with 16 sacks of gel mud. Pulled rest of casing. Bailed hole to 250', set a 10' rock bridge and ran 20 sacks of cement. Mudded the hole to 35', set a 5' rock bridge and ran 10 sacks of cement to base of cellar.

RECEIVED
STATE CORPORATION COMMISSION

APR 17 1958

CONSERVATION DIVISION
WICHITA, KANSAS

(If additional description is necessary, use BACK of this sheet)
Name of Plugging Contractor West Supply Co., Inc. 4-17-58
Address Chase, Kansas

STATE OF KANSAS, COUNTY OF RICE, ss.

(employee of owner) or (owner or operator) of the above-described well, being first duly sworn on oath, says: That I have knowledge of the facts, statements, and matters herein contained and the log of the above-described well as filed and that the same are true and correct. So help me God.

(Signature) Neil J. Knight
Chase, Ks. (Address)

SUBSCRIBED AND SWORN to before me this 16th day of April 19 58

My commission expires 9-27-58
Thomas V. Soopir Notary Public.

PLUGGING
FILE SEC 12 T. 23 R. 10 W.
BOOK PAGE 87 LINE 7

WELL LOG BUREAU KANSAS GEOLOGICAL SOCIETY
412 Union National Bk. Bldg., Wichita, Kansas


15-155-02700.0000

Company LION OIL CO.
Farm Weideroder No. 3

SEC. 12 T. 23 R. 10 W
CN/2 NW SW

Total Depth. 3765'
Comm. 11-2-45 Comp. 12-31-45
Shot or Treated. 500 Gals. Acid.
Contractor.
Issued. 6-1-46

County. Reno
KANSAS

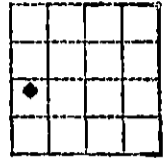

CASING:
8 5/8" 327' Cem.
5 1/2" 3759' Cem.

Elevation. _____

Production. Phy. Pot. 94 BOFD

Figures Indicate Bottom of Formations.

sand & clay	0-100
shale & red bed	1325
anhydrite	1420
lime	1535
lime & shale	1740
lime	1845
lime & shale	2655
shale	2780
shale & lime	2870
lime	2990
lime & shale	3190
lime	3275
cherty lime	3365
lime	3565
cherty lime	3630
lime & shale	3645
shale	3757
lime	3759
Viola lime	3765 (drilling deeper w/cable tools)
Total Depth.	
Top of Viola	3758'

LOGGING
FILE SEC. 12 T. 23 R. 10 W
CN/2 NW SW 87 LINE 9