


WELL PLUGGING RECORD

Give All Information Completely
Make Required Affidavit
Mail or Deliver Report to:
Conservation Division
State Corporation Commission
211 No. Broadway
Wichita, Kansas

Reno County. Sec. 12 Twp. 23 Rge. 10 (E) W (W)
Location as "NE/CNW%SW%" or footage from lines SWc SW
Lease Owner West Supply Co., Inc.
Lease Name Weideroder #2 Well No. _____
Office Address Chase, Kansas
Character of Well (completed as Oil, Gas or Dry Hole) _____
Date well completed _____ 19____
Application for plugging filed _____ 19____
Application for plugging approved _____ 19____
Plugging commenced 3-26-58 19____
Plugging completed 3-31-58 19____
Reason for abandonment of well or producing formation _____

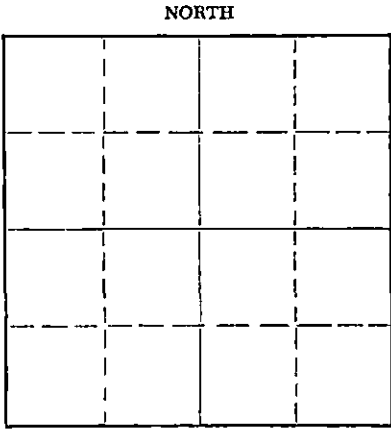

Locate well correctly on above
Section Flat

If a producing well is abandoned, date of last production _____ 19____
Was permission obtained from the Conservation Division or its agents before plugging was commenced? yes

Name of Conservation Agent who supervised plugging of this well Fred Hampel
Producing formation _____ Depth to top _____ Bottom _____ Total Depth of Well 3759 Feet
Show depth and thickness of all water, oil and gas formations.

OIL, GAS OR WATER RECORDS

CASING RECORD

FORMATION	CONTENT	FROM	TO	SIZE	PUT IN	PULLED OUT
				8-5/8"	291'	none
				5-1/2"	3752'	2778'

Describe in detail the manner in which the well was plugged, indicating where the mud fluid was placed and the method or methods used in introducing it into the hole. If cement or other plugs were used, state the character of same and depth placed, from _____ feet to _____ feet for each plug set.

Checked the hole to 3759' and found it open. Filled w/sand to 3740' and ran 5 sacks of cement with dump bailer. Pulled casing to 1700' and circulated with 15 sacks of gel mud. Pulled rest of casing. Bailed hole to 250', set a 10' rock bridge and ran 20 sacks of cement. Mudded the hole to 35', set a rock bridge and ran 10 sacks of cement to base of cellar. 4-17-58

(If additional description is necessary, use BACK of this sheet)
Name of Plugging Contractor West Supply Co., Inc.
Address Chase, Kansas

STATE OF KANSAS, COUNTY OF RICE, ss.
_____(employee of owner) or (owner or operator) of the above-described well, being first duly sworn on oath, says: That I have knowledge of the facts, statements, and matters herein contained and the log of the above-described well as filed and that the same are true and correct. So help me God.

(Signature) Welf Knight
Chase, Kansas (Address)

SUBSCRIBED AND SWORN to before me this 16th day of April, 19 58
Thomas V. Daggir
My commission expires 9-27-58 Notary Public.

F 10013
FILE NO. 121.23 R 104
BOOK PAGE 87 LINE 8


15-155-62199-0000

LION OIL REFG.CO.
 H.P.Weideroder No. 21

SEC.12 T.23 R. 10 W
 SWc SW

Total Depth. 3759'
 Comm. 5-18-42 Comp. 6-8-42
 Shot or Treated, 6-5-42 1000 Gals.
 Contractor. R.W.Rine Drlg.Co.
 Issued. 7-11-42

County. Reno

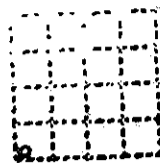

CASING:
 8 5/8" 291' Cem.
 5 1/2" 3752' Cem.

Elevation.

Production. Pot.40,058 B.

Figures Indicate Bottom of Formations.

surface clay & sand	130
red bed	291
red bed & shale	475
shale & shells	1000
salt	1150
shale	1305
lime brkn	1413
lime & shale	1505
lime sdy	1575
shale	1755
lime brkn	1815
lime & shale	2070
lime brkn	2226
shale & shells	2330
lime & shale	2490
shale sticky	2590
shale & shells	2675
lime & shale	2785
lime	3066
lime & shale	3212
shale	3262
lime	3284
lime & shale	3340
shale	3396
lime	3573
chert	3613
shale	3619
chert	3630
shale	3750
lim.	3759
Total Depth.	

Tops: Kansas City lime 3260
 Viola lime 3753

Standardized at 3752

RECEIVED
 STATE CORP. COMMISSION

MAR 6 1958

CONSERVATION DIVISION
 Wichita, Kansas

INDEXING
 SEC. 12 T. 23 R. 10 W
 BOOK PAGE 07 LINE 8