


Give All Information Completely
Make Required Affidavit
Mail or Deliver Report to:
Conservation Division
State Corporation Commission
211 No. Broadway
Wichita, Kansas

WELL PLUGGING RECORD

15-073.00035-0000

NORTH

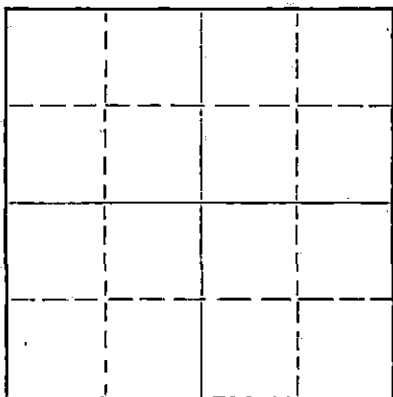

Locate well correctly on above
Section Plat

Greenwood County. Sec. 34 Twp. 23S Rge. 9 (E) (W)
Location as "NE/CNW/SW" or footage from lines NE SE NW
Lease Owner Bedell - Catt Drilling Company
Lease Name Zebold Well No. 1
Office Address 701 Petroleum Bldg. - Wichita, Kansas
Character of Well (completed as Oil, Gas or Dry Hole) Dry hole
Date well completed Dec. 26, 19 57
Application for plugging filed Dec. 26 19 57
Application for plugging approved Dec. 26 19 57
Plugging commenced Dec. 26 19 57
Plugging completed Dec. 26 19 57
Reason for abandonment of well or producing formation

If a producing well is abandoned, date of last production 19
Was permission obtained from the Conservation Division or its agents before plugging was commenced? yes

Name of Conservation Agent who supervised plugging of this well A. W. Harsook
Producing formation Depth to top Bottom Total Depth of Well Feet
Show depth and thickness of all water, oil and gas formations.

OIL, GAS OR WATER RECORDS

CASING RECORD

FORMATION	CONTENT	FROM	TO	SIZE	PUT IN	PULLED OUT
Bartlesville		2294	2404			
Durgess		2404	2411			
Mississippi		2411	2419			

Describe in detail the manner in which the well was plugged, indicating where the mud fluid was placed and the method or methods used in introducing it into the hole. If cement or other plugs were used, state the character of same and depth placed, from feet to feet for each plug set.

Set plug @155'. Sumped 1 sack hulls and 10 sacks cement. Filled hole with mud to 30'. Set plug and cemented W/10 sacks cement.

RECEIVED
STATE CORPORATION COMMISSION
JAN 10 1958
CONSERVATION DIVISION
Wichita, Kansas

(If additional description is necessary, use BACK of this sheet)
Name of Plugging Contractor L. C. Smitherman Drilling Company
Address Box 627 - Augusta, Kansas

STATE OF Kansas, COUNTY OF Butler, ss.
Joe W. Cain (employee of owner) or (owner or operator) of the above-described well, being first duly sworn on oath, says: That I have knowledge of the facts, statements, and matters herein contained and the log of the above-described well as filed and that the same are true and correct. So help me God.

(Signature) Joe W. Cain
Box 627 - Augusta, Kansas
(Address)

SUBSCRIBED AND SWORN to before me this 2nd day of January, 1958

My commission expires January 28, 1961

Shirley Ann Jackson
Shirley Ann Jackson Notary Public.

PLUGGING
FILE SEC 34 T 23 R 9
BOOK PAGE 72 LINE 35

15-673-00035-0000

ZEBOLD #1

Company:	Bedell - Catt Drilling Co.	Location:	NE SE NW, Sec. 34-23S-9E,
Contractor:	L. C. Smitherman Drilling Co.		Greenwood County, Kansas
Commenced:	December 20, 1957	Elevation:	KB - 1376
Completed:	December 26, 1957	Casing:	102" - 8 5/8" cemented w/110 Sks.

Figures Indicate Bottoms of Formations:

0	102	Soil, lime & shale breaks
102	571	Shale w/lime streaks
571	825	Lime and shale
825	1100	Lime and shale breaks
1100	1567	Shale and lime
1567	1695	Shale shells
1695	1849	Lime and shale
1849	2050	Lime and shale breaks
2050	2191	Shale shells
2191	2307	Lime and shale
2307	2350	Lime and shale breaks
2350	2410	Shale shells
2410	2460	Lime
2460		Total depth

We hereby certify the above and foregoing to be a true and correct copy of the Log on the Zebold #1, located in the NE SE NW, of Section 34-23S-9E, Greenwood County, Kansas.

L. C. SMITHERMAN DRILLING COMPANY

Carl J. Lehr
Carl J. Lehr

Subscribed and sworn to before me this 2nd day of January, 1958.

Shirley Ann Jackson
(Notary Public)

My commission expires January 28, 1961.

PLUGGING
FILE SEC 34 T 23 R 9E
BOOK PAGE 72 LINE 35