


STATE OF KANSAS  
STATE CORPORATION COMMISSION

Give All Information Completely  
Make Required Affidavit  
Mail or Deliver Report to:  
Conservation Division  
State Corporation Commission  
800 Bitting Building  
Wichita, Kansas

15-009-03081-0000  
WELL PLUGGING RECORD

NORTH

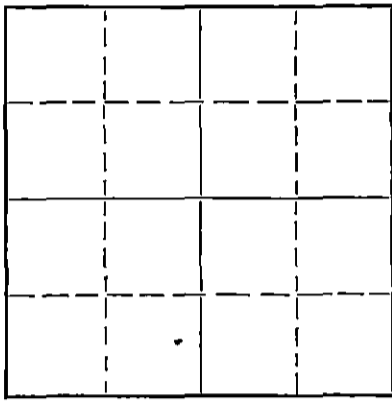

Locate well correctly on above  
Section Flat

Barton County. Sec. 21 Twp. 16 Rge. (E) 11 (W)  
Location as "NE/CNW $\frac{1}{4}$ SW $\frac{1}{4}$ " or footage from lines C S/2 N/2 SE/4  
Lease Owner Morganstern & Specter  
Lease Name Seyfert Well No. 5  
Office Address Russell, Kansas  
Character of Well (completed as Oil, Gas or Dry Hole) Oil  
Date well completed 3-25 19 49  
Application for plugging filed November 26, 1955 19  
Application for plugging approved November 28, 1955 19  
Plugging commenced 12-15 19 55  
Plugging completed 12-18 19 55  
Reason for abandonment of well or producing formation failure to produce  
profitably  
If a producing well is abandoned, date of last production November 1955 19  
Was permission obtained from the Conservation Division or its agents before plugging was commenced? Yes

Name of Conservation Agent who supervised plugging of this well Brundage  
Producing formation Arbuckle Depth to top 3364 Bottom 3389' Total Depth of Well 3389' Feet  
Show depth and thickness of all water, oil and gas formations.

OIL, GAS OR WATER RECORDS

CASING RECORD

Formation	Content	From	To	Size	Put In	Pulled Out
		0	277	8 5/8"	277'	None
		0	3366	5 1/2"	3366'	2389-27'

Describe in detail the manner in which the well was plugged, indicating where the mud fluid was placed and the method or methods used in introducing it into the hole. If cement or other plugs were used, state the character of same and depth placed, from \_\_\_\_\_ feet to \_\_\_\_\_ feet for each plug set.

Sanded hole to 3360 - dumped 5 sks cement -  
mudded to 275' - set 10' rock bridge - mudded to 35' -  
set bridge - dumped 10 sks cement.

(If additional description is necessary, use BACK of this sheet)  
Name of Plugging Contractor R & D Casing Pulling Company License # 236  
Correspondence regarding this well should be addressed to Box 569 Ellinwood, Kansas  
Address Box 569 Ellinwood, Kansas

STATE OF Kansas, COUNTY OF Russell, ss.  
Morganstern & Specter (employee of owner) or (owner or operator) of the above-described well,  
being first duly sworn on oath, says: That I have knowledge of the facts, statements, and matters herein contained and the log of the above-described well as filed and that the same are true and correct. So help me God.

(Signature) Arthur Morganstern  
Box 661  
(Address)

SUBSCRIBED AND SWORN to before me this 22nd day of December, 19 55

My commission expires Dec. 1, 1959

Elsie Coady  
Elsie Coady  
Notary Public.

28-5091-s 8-50-10M

**PLUGGING**  
FILED SEC 21 T. 16 R. 11 W  
BOOK PAGE 20 LINE 1

DEC 23 1955  
12-23-55  
CONSERVATION DIVISION  
Wichita, Kansas

WELL LOG BUREAU--KANSAS GEOLOGICAL SOCIETY  
412 Union National Bk. Bldg., Wichita, Kansas

Company - ANDERSON-PRICHARD OIL CORP.  
Farm - Soyfert No. 5

SEC. 21 T. 16 R. 11W  
CS  $\frac{1}{2}$  N  $\frac{1}{2}$  SE

Total Depth. 3389'  
Comm. 2-15-49 Comp. 3-25-49  
Shot or Treated. Shot 20 qts. 3383-89  
Contractor. Transit Corporation  
Issued. 4-30-49

County. Barton  
KANSAS



Elevation. \_\_\_\_\_

Production. Phy. Pot. 31 BOPD &  
55% water

CASING:

8-5/8" 277' Cem. W/200 Sx,  
5-1/2" 3366' Cem. W/150 Sx,

Figures Indicate Bottom of Formations.

surface clay & rock	110
sand, shale & shells	165
shale	575
red bed & shale	745
anhydrite	775
shale & shells	1425
shale & lime	1880
lime	2135
lime & shale	2910
lime	3280
lime cherty	3315
lime	3365
lime & chert	3375
lime?	3389
Total Depth	

Tops:	
Anhydrite	760
Lansing	3073
Conglomerate	3352
Arbuckle	3364

15 BOPD: Shot 20 qts. 3383-89  
Swab. 25 BO & 25 BW, 24 hrs.

RECEIVED  
STATE CORPORATION COMMISSION  
NOV 28 1955  
CONSERVATION DIVISION  
Wichita, Kansas

PLUGGING  
FILE SEC 21 T 16 R 11W  
BOOK PAGE 20 LINE 1