

WELL PLUGGING RECORD

OR


15-009-1504-8880

~~WELL PLUGGING RECORD~~

Strike out upper line when reporting plugging of formations.

Give All Information Completely
Make Required Affidavit
Mail or Deliver Report to:
Conservation Division
State Corporation Commission
800 Bitting Building
Wichita, Kansas

NORTH

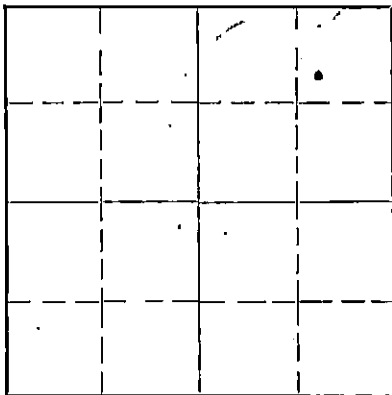

Locate well correctly on above Section Plat

Location as "NE $\frac{1}{4}$ NW $\frac{1}{4}$ SW $\frac{1}{4}$ " or footage from lines Barton County. Sec. 21 Twp. 16S Rge. 11 NE (W)
NE $\frac{1}{4}$, 990' fm Nth 440' fm West
Lease Owner Sinclair Prairie Oil Co
Lease Name Henry W. Leudick Well No. one
Office Address Box 521, Tulsa, Okla
Character of Well (Completed as Oil, Gas or Dry Hole) dry hole
Date, well completed April 4 1939
Application for plugging filed April 8 1939
Application for plugging approved by letter- April 10 1939
Plugging Commenced April 7 1939
Plugging Completed April 8 1939
Reason for abandonment of well or producing formation dry hole
If a producing well is abandoned, date of last production - 1939
Was permission obtained from the Conservation Division or its agents before plugging was commenced?
yes

Name of Conservation Agent who supervised plugging of this well Ed Shell
Producing formation Arbuckle Lime Depth to top 3358 $\frac{1}{2}$ Bottom 3363 Total Depth of Well 3363 Feet.
Show depth and thickness of all water, oil and gas formations.


OIL, GAS OR WATER RECORDS

CASING RECORD

Formation	Content	From	To	Size	Put In	Pulled Out
<u>Kas City</u>	<u>dry</u>	<u>3040</u>		<u>10"</u>	<u>125'</u>	<u>none</u>
<u>Arbuckle</u>	<u>dry</u>	<u>3358$\frac{1}{2}$</u>	<u>TD 3363</u>			

Describe in detail the manner in which the well was plugged, indicating where the mud fluid was placed and the method or methods used in introducing it into the hole. If cement or other plugs were used, state the character of same and depth placed, from _____ feet to _____ feet for each plug set.

Rotary drlg mud 3363'-125'
Wood Plug & 20 sx cmt 125- 105'
Mud 105- 10'
Cement-10 sx 10'- to bottom of cellar
Welded cap on top of surface pipe

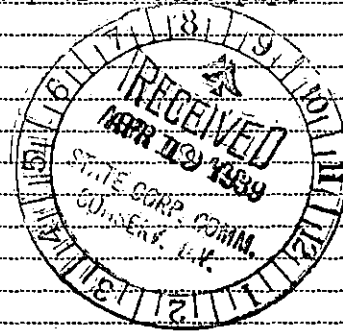

recd
04-19-1939

PLUGGING
FILE SEC 21-16R-114
BOOK PAGE 57 LINE 26

(If additional description is necessary, use BACK of this sheet)

Correspondence regarding this well should be addressed to Mr. J.B. Rowland
Address Box 650, McPherson, Kas

STATE OF _____, COUNTY OF _____, ss.
I, J.B. Rowland (employee of owner) or ~~known as operator~~ of the above-described well,
being first duly sworn on oath, says: That I have knowledge of the facts, statements, and matters herein contained and the log of the above-described well as filed and that the same are true and correct. So help me God.

(Signature) J.B. Rowland
Box 650, McPherson, Kas
(Address)

SUBSCRIBED AND SWORN to before me this 18th day of April 1939
Jan 28 1943
My commission expires _____
[Signature] Notary Public.

Sinclair Prairie Oil Co
Well Log


Henry W. Laudick #1
990' fm Nth & 440' fm West Lines
NE/4, 21-16S-11W Barton County, Kas
Elevation 1890'

Harbar Drlg Co
Began drlg 3/19/39
Comp. " 4/5/39
Rotary tools to TD 3363
Dry hole in Arbuckle Lime
Very small oil show at TD

Surface Clay	125	125
Shale & Shells		270
Water-Sand		314
Shale & Shells		520
Red Bed & Shale		725
Anhydrite		775
Shale & Shells		950
Shale		1010
Shale & Shells		1153
Salt		1180
Salt & Shale		1375
Shale & Shells		1440
Lime		1500
Anhydrite-Shale		1560
Shale		1590
Shale & Lime Shells		1700
Lime		1718
Shale & Sand		1748
Lime		1845
Broken Lime		1865
Lime & Shale		1940
Lime		2025
Red Bed		2042
Lime		2100
Lime & Red Bed		2150
Shale & Lime Shells		2280
Shale		2304
Shale & Shells		2340
Shale		2395
Shale & Lime		2455
Shale & Shells		2462
Lime		2478
Shale & Lime Shells		2515
Shale & Lime		2533
Lime		2543
Shale & Lime		2570
Shale & Shells		2580
Lime		2648
Shale & Lime		2680
Broken Sandy Lime & Shale		2697
Lime		2704
Shale & Lime		2727
Lime		2760
Sandy Lime		2800
Shale & Lime		2812
Lime		2955
Broken Lime & Shale		2982
Lime & Shale		2990
Shale		3033
Lime		3050
Shale		3065
Lime		3122
Lime & Shale		3130
Hard Lime		3141
Soft Lime		3159
Hard Lime		3210
Soft Lime		3217
Hard Lime		3233
Soft Lime		3240
Hard Lime		3256
Soft Lime		3260
Lime		3297
Lime & Shale		3299
Lime		3330
Broken Lime		3343
Chert & Red Rock		3345
Lime & Shale		3347
Chert & Shale		3349
Shale & Lime		3352
Conglomerate		3358
Arbuckle top 3363		3363 TD

Csg Record
125' 10" 40# LW csg
left in hole

Plugged & abandoned 4/8/39

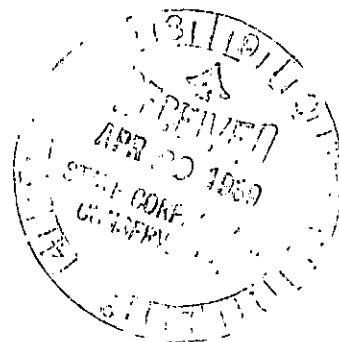

Sinclair Prairie Oil Co
Well Log

Henry V. Laudick #1
990' fm Nth & 440' fm West Lines
NE/4, 21-16S-11W Barton County, Kas
Elevation 1890'

Harbar Drig Co
Began drlg 3/19/39
Comp. " 4/5/39
Rotary tools to TD 3363
Dry hole in Arbuckle Lime
Very small oil show at TD

Surface Clay	125	125
Shale & Shells		270
Water-Sand		314
Shale & Shells		520
Red Bed & Shale		725
Anhydrite		775
Shale & Shells		950
Shale		1010
Shale & Shells		1153
Salt		1180
Salt & Shale		1375
Shale & Shells		1440
Lime		1500
Anhydrite-Shale		1560
Shale		1590
Shale & Lime Shells		1700
Lime		1718
Shale & Sand		1743
Lime		1845
Broken Lime		1865
Lime & Shale		1940
Lime		2026
Red Bed		2042
Lime		2100
Lime & Red Bed		2130
Shale & Lime Shells		2250
Shale		2304
Shale & Shells		2340
Shale		2395
Shale & Lime		2435
Shale & Shells		2462
Lime		2478
Shale & Lime Shells		2515
Shale & Lime		2536
Lime		2545
Shale & Lime		2570
Shale & Shells		2630
Lime		2643
Shale & Lime		2680
Broken Sandy Lime & Shale		2697
Lime		2704
Shale & Lime		2727
Lime		2760
Sandy Lime		2800
Shale & Lime		2812
Lime		2935
Broken Lime & Shale		2982
Lime & Shale		2990
Shale		3033
Lime		3050
Shale		3066
Lime		3122
Lime & Shale		3150
Hard Lime		3161
Soft Lime		3159
Hard Lime		3210
Soft Lime		3217
Hard Lime		3255
Soft Lime		3240
Hard Lime		3256
Soft Lime		3260
Lime		3297
Lime & Shale		3299
Lime		3350
Broken Lime		3345
Chert & Red Rock		3345
Lime & Shale		3347
Chert & Shale		3349
Shale & Lime		3352
Conglomerate		3358
Arbuckle top 3363		3363 TD

Csg Record

125' 10" 40# LW. csg
left in-hole

Plugged & abandoned 4/8/39

