


STATE OF KANSAS
STATE CORPORATION COMMISSION

15-009-07402-0000

Form CP-4

Give All Information Completely
Make Required Affidavit
Mail or Deliver Report to:
Conservation Division
State Corporation Commission
P. O. Box 17027
Wichita, Kansas 67217
NORTH

WELL PLUGGING RECORD

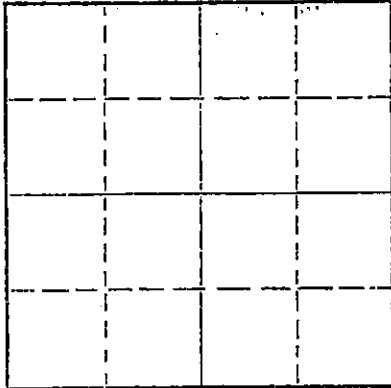

Locate well correctly on above
Section Plat

Location as "NE/CNW/SW" or footage from lines Barton County, Sec. 18 Twp. 16 Rge. 11 (E) (W) X
C SE NW SE

Lease Owner Okmar Oil Co.
Lease Name Redetzke Well No. #9
Office Address 1130 Vickers KSB&T Bldg. Wichita, Kansas
Character of Well (completed as Oil, Gas or Dry Hole) _____
Date well completed _____ 19____
Application for plugging filed 5-15-72 19____
Application for plugging approved _____ 19____
Plugging commenced 5-19-72 19____
Plugging completed 5-26-72 19____
Reason for abandonment of well or producing formation _____

If a producing well is abandoned, date of last production _____ 19____
Was permission obtained from the Conservation Division or its agents before plugging was commenced? _____

Name of Conservation Agent who supervised plugging of this well Donald Truan
Producing formation _____ Depth to top _____ Bottom _____ Total Depth of Well 3296' Feet
Show depth and thickness of all water, oil and gas formations.

OIL, GAS OR WATER RECORDS

CASING RECORD

FORMATION	CONTENT	FROM	TO	SIZE	PUT IN	PULLED OUT
				5 1/2"	3294'	1636.11'
				8 5/8"	372'	

Describe in detail the manner in which the well was plugged, indicating where the mud fluid was placed and the method or methods used in introducing it into the hole. If cement or other plugs were used, state the character of same and depth placed, from _____ feet to _____ feet for each plug set.

Made bottom hole plug back with sand to 3200', mixed and ran 5 sacks cement thru dump bailer.
Plugged hole with 3 sacks hulls - 20 sacks gel and 100 sacks cement.

RECEIVED
STATE CORPORATION COMMISSION
MAY 31 1972
05-31-72
CONSERVATION DIVISION
Wichita, Kansas

(If additional description is necessary, use BACK of this sheet)
Name of Plugging Contractor Southwest Casing Pulling Co.
Address Box 364 Great Bend, Kansas

STATE OF Kansas, COUNTY OF Barton, ss.
Southwest Casing Pulling Co. (employee of owner) or (owner or operator) of the above-described well, being first duly sworn on oath, says: That I have knowledge of the facts, statements, and matters herein contained and the log of the above-described well as filed and that the same are true and correct. So help me God.

(Signature) W. C. Spencer Sec.
Box 364 Great Bend, Kansas
(Address)

SUBSCRIBED AND SWORN TO before me this 26 day of May, 1972

My commission expires October 1972
Sidney D. Miller
Notary Public.



WELL LOG BUREAU--KANSAS GEOLOGICAL SOCIETY
500 East Murdock, Wichita, Kansas


COPY

Company- BRUNSON DRILLING CO.
Farm- Redetzke No.9

SEC. 18 T. 16 R. 11W
180' East of CSL NW SE

Total Depth. 3296
Comm. 7-23-55 Comp. 8-1-55
Shot or Treated.
Contractor. Brinrich Drilling Co., Inc.
Issued. 10-1-55

County Barton
KANSAS

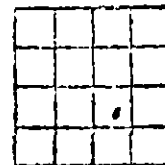

CASING:

8 5/8 372'
5 1/2 3294'

Elevation. 1875 RB

Production. 25 BOPD

Figures in feet Bottom of Formation.

rock	30
shale	150
sandy shale	192
sand	345
shale	450
pyrite & shale	504
red bed	698
anhydrite	725
shale & shells	825
shale, shells & salt	955
shale & shells	1380
shale & lime	1669
broken lime	1830
lime	1905
broken lime	2075
shale	2235
shale & shells	2450
lime & shale	2930
lime	2945
shale & lime	3008
lime	3296
Total Depth	

TOPS:	
Anhydrite	698
Heebner	2914
Toronto	2929
Oread	2944
Brown lime	3007
Lansing	3026
Kansas City	3225
Arbuckle	3293

RECEIVED
STATE CORPORATION COMMISSION
MAY 16 1972
CONSERVATION DIVISION
Wichita, Kansas