

STATE OF KANSAS
STATE CORPORATION COMMISSION

Form CP-4

Give All Information Completely
Make Required Affidavit
Mail or Deliver Report to:
Conservation Division
State Corporation Commission
212 No. Market
Wichita, Kansas

WELL PLUGGING RECORD

Finney County, Sec. 27 Twp. 22S Rge. (E) 33 (W)

Location as "NE/CNW/SW" or footage from lines C NE SW

Lease Owner Champlin Petroleum Company

Lease Name E. R. Adams Well No. 4

Office Address 6441 NW Grand Blvd. Suite 300, Oklahoma City, OK 73116

Character of Well (completed as Oil, Gas or Dry Hole) Dry Hole

Date well completed 2-23 19 81

Application for plugging filed 9-11 19 81

Application for plugging approved 9-22 19 81


Plugging commenced 11-25 19 81

Plugging completed 12-01 19 81

Reason for abandonment of well or producing formation non productive

If a producing well is abandoned, date of last production -- 19 --

Was permission obtained from the Conservation Division or its agents before plugging was commenced? Yes

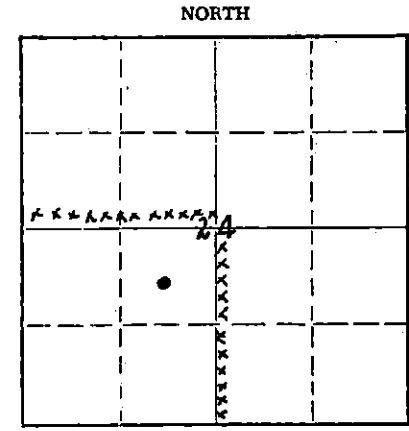

Locate well correctly on above Section Plat

Name of Conservation Agent who supervised plugging of this well Mr. Clarence Thomas

Producing formation Test - Toronto-Dry Depth to top 3814 Bottom 3825 Total Depth of Well 4900 Feet

Show depth and thickness of all water, oil and gas formations.

OIL, GAS OR WATER RECORDS

CASING RECORD

FORMATION	CONTENT	FROM	TO	SIZE	PUT IN	PULLED OUT
				8-5/8"	1055'	0'
				5-1/2"	4900'	1530'

Describe in detail the manner in which the well was plugged, indicating where the mud fluid was placed and the method or methods used in introducing it into the hole. If cement or other plugs were used, state the character of same and depth placed, from _____ feet to _____ feet for each plug set.

DEC 15 1981

11-25-81 Move in Midwest Casing Pulling rig. Dig out cellar & remove slips from casing hanger.

11-26-81 Shut down for holiday.

11-27-81 Pump 4 sxs hulls & 75 sxs cement across perforations from PBTB @ 3900' to 3450'. Pressure test @ 1000#. Shot 5-1/2" csg @ 2418'. Work pipe w/14" stretch. Pipe did not come loose. Ran free point. Pipe free @ 1400'.

11-28-81 Shot casing @ 1827'. Work pipe with 14" stretch. did not come loose. Shot pipe @ 1530'. Pipe came loose. Pull up to 1046'. SDFN.

11-29-81 Shut down for Sunday.

11-30-81 Shut down due to weather.

12-01-81 Pump 50 sxs cement from 850' to 1000'. Pull remainder of 5-1/2" casing. Clean out cellar. Run a bridge and 12 sxs cement from 0' to 40'. Cut 8-5/8" @ 4' below ground level. Weld on plate. Fill cellar. Release rig. Well P&A.

12-15-81

Name of Plugging Contractor Midwest Casing Pulling Service

Address P. O. Box F Sublette, Kansas 67877

STATE OF Oklahoma, COUNTY OF Oklahoma

J. W. Meyers (employee of owner) or (owner or operator) of the above-described well, being first duly sworn on oath, says: That I have knowledge of the facts, statements, and matters herein contained and the log of the above-described well as filed and that the same are true and correct. So help me God.

(Signature) [Handwritten Signature]

6441 N.W. Grand Blvd., Atrium Towers North #300 Oklahoma City, OK (Address)

SUBSCRIBED AND SWORN to before me this 4th day of December, 19 81

My commission expires 10-08-83

Notary Public.

CHAPLIN PETROLEUM CO.

E. R. ADAMS #4 WELL
FINNEY COUNTY, KANSAS

OPERATIONS COMMENCED: 10/28/80

OPERATIONS COMPLETED: 11/11/80

DRILLING LOG

10/28	0 - 194	Sand, Gyp.
10/29	194 - 1060	Sand, Gyp.
10/30	1060 - 1440	Gyp, Slale
10/31	1440 - 2475	Shale, Lime
11/01	2475 - 2937	Shale, Lime
11/02	2937 - 3303	Shale, Lime
11/03	3303 - 3710	Shale, Lime
11/04	3710 - 4075	Shale, Lime
11/05	4075 - 4365	Shale, Lime
11/06	4365 - 4510	Shale, Lime
11/07	4510 - 4703	Shale, Lime
11/08	4708 - 4900	Shale, Lime

CASING RECORD

10/29

Ran 23 jts. new 8 5/8 24# casing w/guide shoe Float insert cement surface pipe w/500 sks 35/65 Poz T 150 sks Class H w/2% C.C.

11/11

Run long string, hit bridge @ 1400 would not go, lay 5 1/2 casing down #14# w/guide shoe float colar. Cement w/250 sks Class H w/18% salt.

RECEIVED
STATE CORPORATION COMMISSION

SEP 14 1981

CONSERVATION DIVISION
Wichita, Kansas